

SEWER BUILDERS RETURN

I HEREBY CERTIFY that the within connection enters lot at a point 25'-0" feet South of NORTH LOT line of said lot and was properly made by me on 27th day of May 1925 in conformity with the specifications of Sanitary Engineering Department; that the connection was made with the recorded Y branch or connection for said lot without opening or in any way injuring the main sewer; that said connection was laid to a true and proper grade, and constructed of sound and substantial 5" sewer pipe, with the joints properly cemented and tight and that the whole was left in clean and good condition.


Measurement used was 115' feet from MH Depth of connection at point of tap 9'-2"
Depth of connection at lot line 8'-0" Connection in house made to Basement Wall, only

Roofwater ~~will be~~ is (not) conducted under my contract to

Frank George Co
By S. H. Vance
Licensed Sewer Builder

Approved W. M. Hynds Inspector

Dakbrygh St

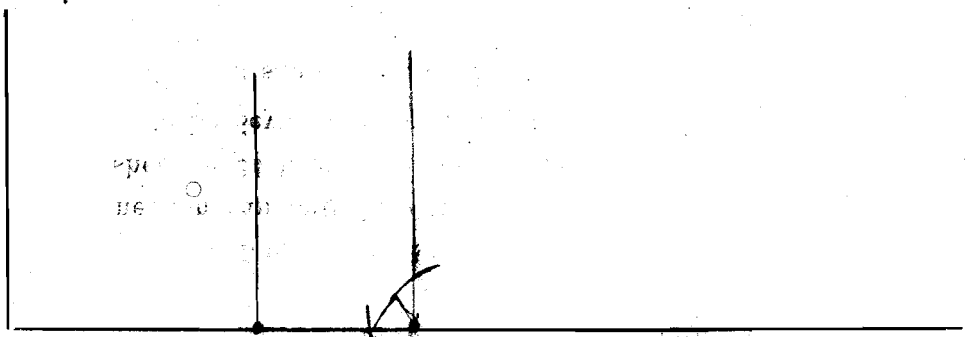

Palmer

Forest Hill Ave

10+20 R
MH 11+35

This plan should show street names and distances to manholes from Y or lateral being connected.

Permit No. 1

Quinton Ave
Sewer District

SEWER CONNECTION

Lot No. 322 A

Subdivision Wickliffe Annex

Street Forest Hill Ave

Recorded in Sewer Book

Vol. 3, Pg. 134

58
JUL 10 1925
RECORDED
INDEXED