


SEWER BUILDERS RETURN

I HEREBY CERTIFY that the within connection enters lot at a point 12 feet North 14th line of said lot and was properly made by me on May day of 1915 in conformity with the specifications of Sanitary Engineering Department; that the connection was made with the recorded Y branch or connection for said lot without opening or in any way injuring the main sewer; that said connection was laid to a true and proper grade, and constructed of sound and substantial 5" sewer pipe, with the joints properly cemented and tight and that the whole was left in clean and good condition.

Measurement used was 79 feet from M.H. 4. Blvd. Depth of connection at point of tap 8 1/2' Depth of connection at lot line 7' Connection in house made to _____ Roofwater will be is (not) conducted under my contract to _____

Approved Joseph Parilla Licensed Sewer Builder
J. J. McLaughlin Inspector

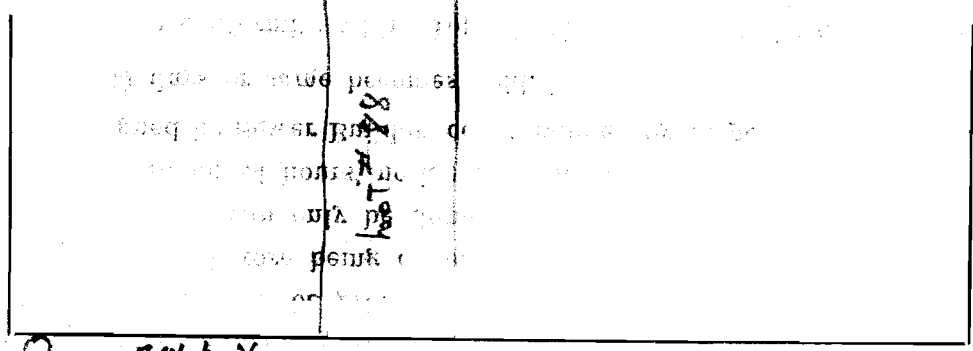

Unkbluff Blvd.

79' to Y

Edgemoor Dr.

This plan should show street names and distances to manholes from Y or lateral being connected.

Duplicate
Permit No. 2

Unkbluff
Sewer District

SEWER CONNECTION

Lot No. 85
Subdivision Unkbluff
Street Edgemoor Ave

Recorded in Sewer Book

Vol. 3, Pg. 103