


SEWER BUILDERS RETURN

I HEREBY CERTIFY that the within connection enters lot at a point 10 feet from north lot line of said lot and was properly made by me on July 1st day of 1915 in conformity with the specifications of Sanitary Engineering Department; that the connection was made with the recorded Y branch or connection for said lot without opening or in any way injuring the main sewer; that said connection was laid to a true and proper grade, and constructed of sound and substantial 5 in sewer pipe, with the joints properly cemented and tight and that the whole was left in clean and good condition.

Measurement used was _____ feet from _____ Depth of connection at point of tap 9'5"
Depth of connection at lot line same Connection in house made to Bath + 2 sink
Roofwater will be to gutter conducted under my contract to _____ is (not) _____

Harry M. Wornley
Licensed Sewer Builder
Approved: E. D. McCarthy
Inspector

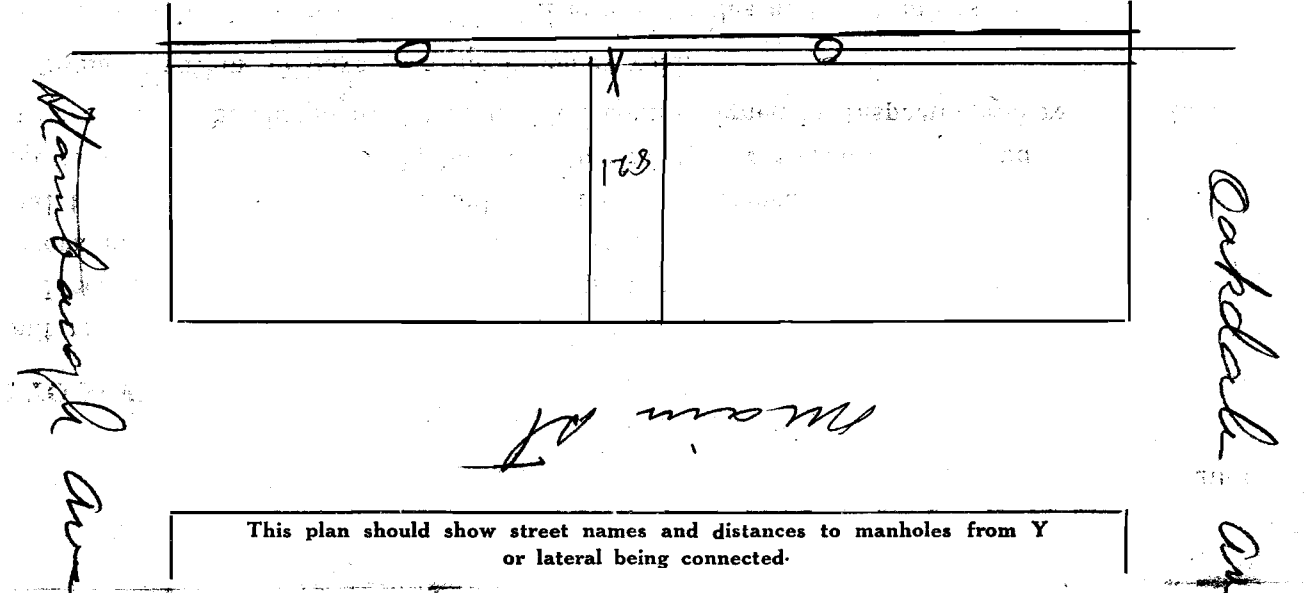

This plan should show street names and distances to manholes from Y or lateral being connected.

Permit No. 4
Anderton
Sewer District

SEWER CONNECTION

Lot No. 821
Subdivision Dickhoff Broadway Plat
Street Rear of Lot on Main St

Recorded in Sewer Book

Vol. 3, Pg. 29