


SEWER BUILDERS RETURN

I HEREBY CERTIFY that the within connection enters lot at a point 12 feet from North lot line of said lot and was properly made by me on July 1 day of: in conformity with the specifications of Sanitary Engineering Department; that the connection was made with the recorded Y branch or connection for said lot without opening or in any way injuring the main sewer; that said connection was laid to a true and proper grade, and constructed of sound and substantial 5 sewer pipe, with the joints properly cemented and tight and that the whole was left in clean and good condition.

Measurement used was stake feet from: Depth of connection at point of tap 9' 10"
Depth of connection at lot line 9 ft 10 in Connection in house made to Bath + 2 sinks
Roofwater will be is (not) conducted under my contract to to gutter

Harry M. Normley
Licensed Sewer Builder
Approved H. M. Normley
Inspector

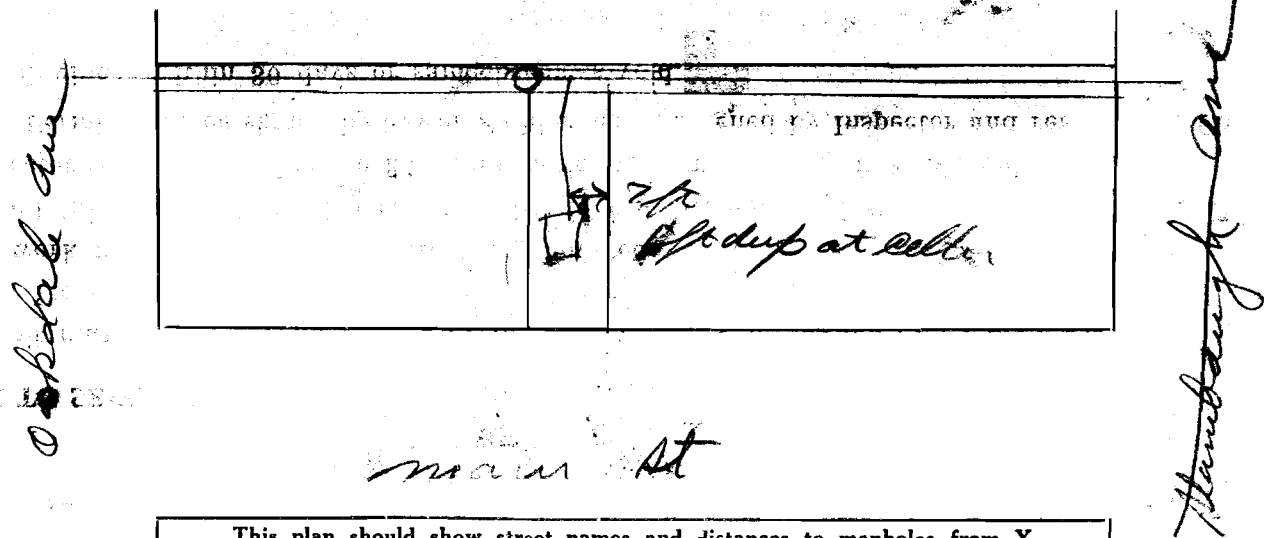

This plan should show street names and distances to manholes from Y or lateral being connected.

Permit No. 5

Austintown
Sewer District

SEWER CONNECTION

Lot No. 768
Subdivision Plot Wickliff Broadview
Street Rear of lot on Main St

Recorded in Sewer Book

Vol. 3, Pg. 33