


**SEWER BUILDERS RETURN**

I HEREBY CERTIFY that the within connection enters lot at a point 7 ft 6 in feet from North to  
 .....line of said lot and was properly made by me on July 1 day of .....  
 in conformity with the specifications of Sanitary Engineering Department; that the connection was made with the recorded Y  
 branch or connection for said lot without opening or in any way injuring the main sewer; that said connection was laid to a  
 true and proper grade, and constructed of sound and substantial 5 sewer pipe, with the joints properly  
 cemented and tight and that the whole was left in clean and good condition.

Measurement used was tape feet from ..... Depth of connection at point of tap 7 ft 2 in  
 Depth of connection at lot line same Connection in house made to Bath + 2 sink

Roofwater will be is (not) conducted under my contract to gutter in street  
Harry M. Womley  
 Licensed Sewer Builder  
 Approved O. B. McCarthy  
 Inspector

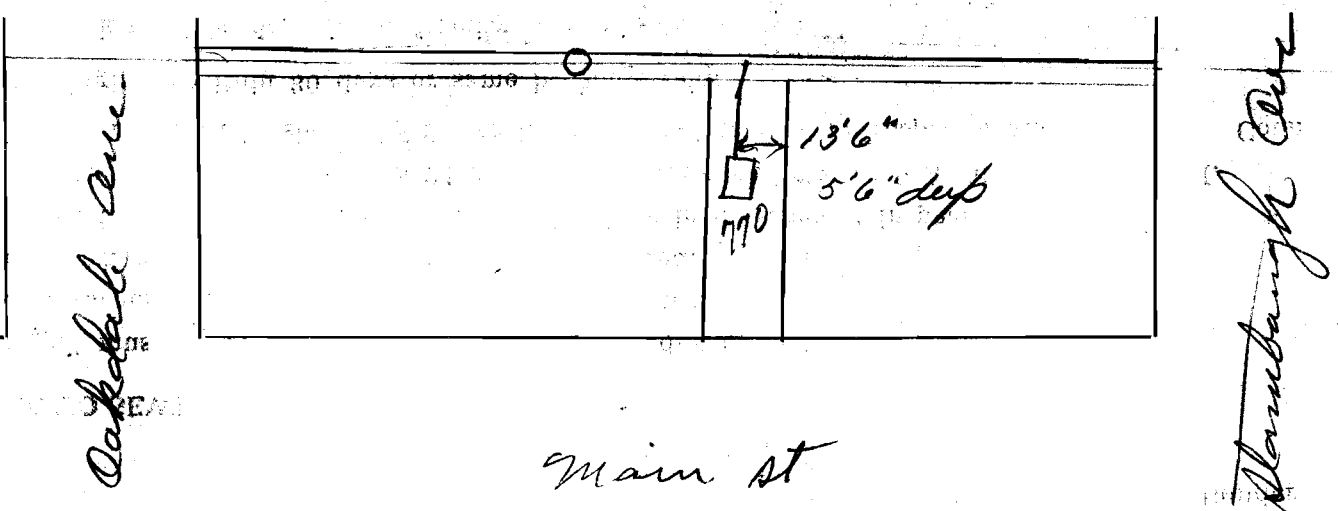

This plan should show street names and distances to manholes from Y  
 or lateral being connected.

Permit No. 6  
Aurora  
 Sewer District

**SEWER CONNECTION**

Lot No. 770  
 Subdivision Wickoff Broadway Plat.  
 Street Rear of St Main St

Recorded in Sewer Book

Vol. 3, Pg. 33

1916  
 JUL 10 1916  
 10 10 1916