


SEWER BUILDERS RETURN

I HEREBY CERTIFY that the within connection enters lot at a point 8 ft 6 in feet from north to
1st line of said lot and was properly made by me on July day of July
in conformity with the specifications of Sanitary Engineering Department; that the connection was made with the recorded Y
branch or connection for said lot without opening or in any way injuring the main sewer; that said connection was laid to a
true and proper grade, and constructed of sound and substantial 5 sewer pipe, with the joints properly
cemented and tight and that the whole was left in clean and good condition.

Measurement used was Stake feet from Depth of connection at point of tap 9 ft 4 in
Depth of connection at lot line same Connection in house made to Bath + 2 sinks
Roofwater will be to gutter conducted under my contract to to gutter
is ~~(not)~~ to gutter

Approved Harry M. Normley
Licensed Sewer Builder
B. O. M. ...
Inspector

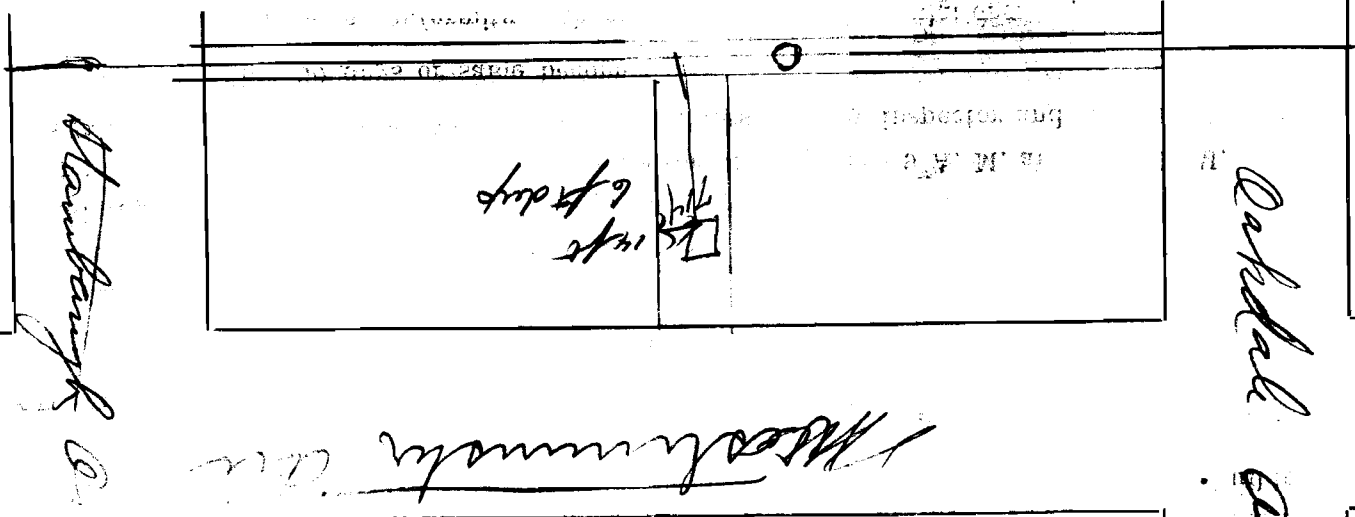

This plan should show street names and distances to manholes from Y or lateral being connected.

Permit No. 8
Washington
Sewer District

SEWER CONNECTION

Lot No. 714
Subdivision Wickliff Broadview Plat
Street Parry Lot Westminster Ave

Recorded in Sewer Book

Vol. 3, Pg. 33