


SEWER BUILDERS RETURN

I HEREBY CERTIFY that the within connection enters lot at a point 18 feet East of West line of said lot and was properly made by me on July 8 day of 1925 in conformity with the specifications of Sanitary Engineering Department; that the connection was made with the recorded Y branch or connection for said lot without opening or in any way injuring the main sewer; that said connection was laid to a true and proper grade, and constructed of sound and substantial five sewer pipe, with the joints properly cemented and tight and that the whole was left in clean and good condition.

Measurement used was 5.2 feet from Mill Street Depth of connection at point of tap 8 feet Depth of connection at lot line 3 feet Connection in house made to 4" pipe at

Roofwater will be not conducted under my contract to Garrett Andrews per copy Licensed Sewer Builder

Approved J. Beckenbach Inspector

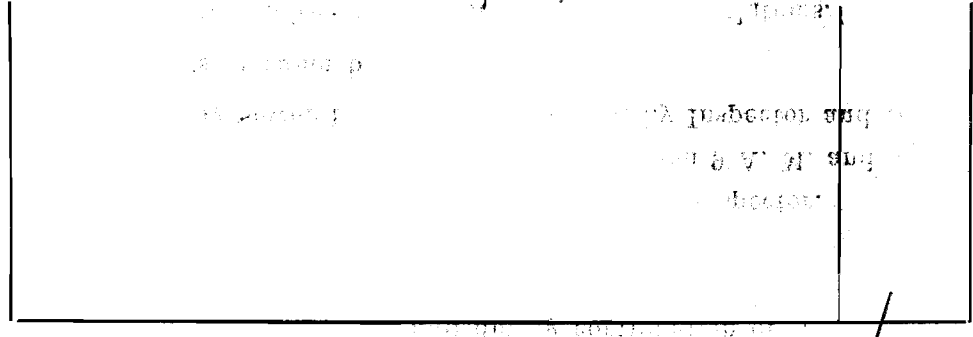

Livingston Place

This plan should show street names and distances to manholes from Y or lateral being connected.

Permit No. 10
Anderson
Sewer District

SEWER CONNECTION

Lot No. 10
Subdivision P.A. Andrews Oakdale Ave Plot
Street Oakdale Ave

Recorded in Sewer Book

Vol. 3, Pg. 17

61-
10366