

SEWER BUILDERS RETURN


I HEREBY CERTIFY that the within connection enters lot at a point 14 ft feet from north line line of said lot and was properly made by me on _____ day of _____ in conformity with the specifications of Sanitary Engineering Department; that the connection was made with the recorded Y branch or connection for said lot without opening or in any way injuring the main sewer; that said connection was laid to a true and proper grade, and constructed of sound and substantial 5 sewer pipe, with the joints properly cemented and tight and that the whole was left in clean and good condition.

Measurement used was 9 x 7 1/2 feet from M.H. 10344 Depth of connection at point of tap 8 ft Depth of connection at lot line same Connection in house made to bath + 2 sinks Roofwater will be conducted under my contract to gutter

Harry M. Stormley
Frank George W. Licensed Sewer Builder
Approved W. M. Fynes

Inspector

Oakdale Ave

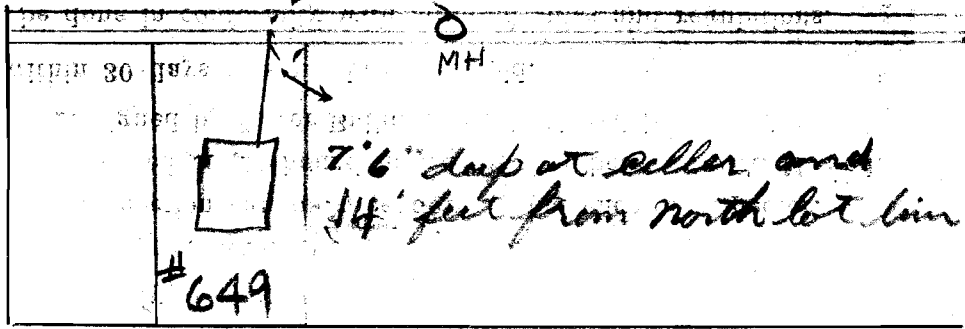

Stambaugh

Westminster Ave

This plan should show street names and distances to manholes from Y or lateral being connected.

Permit No. 125
Anderson
Sewer District

SEWER CONNECTION

Lot No. 649

Subdivision Wickliff Broadway

Street Rear of Westminster Ave

Recorded in Sewer Book

Vol. 3, Pg. 38

side of
for the
by