


SEWER BUILDERS RETURN

I HEREBY CERTIFY that the within connection enters lot at a point 12' feet from North line of said lot and was properly made by me on 4 day of Aug 1925 in conformity with the specifications of Sanitary Engineering Department; that the connection was made with the recorded Y branch or connection for said lot without opening or in any way injuring the main sewer; that said connection was laid to a true and proper grade, and constructed of sound and substantial 5" sewer pipe, with the joints properly cemented and tight and that the whole was left in clean and good condition.

Measurement used was 7.5' feet from Station 11.000 Depth of connection at point of tap 9"
Depth of connection at lot line 4" Connection in house made to Bath + 2 sinks
Roofwater ~~is~~ ^{will be} conducted under my contract to To gutter

Approved Harry M. Stormley Licensed Sewer Builder
W. H. Hynes Inspector

Cakdale Ave

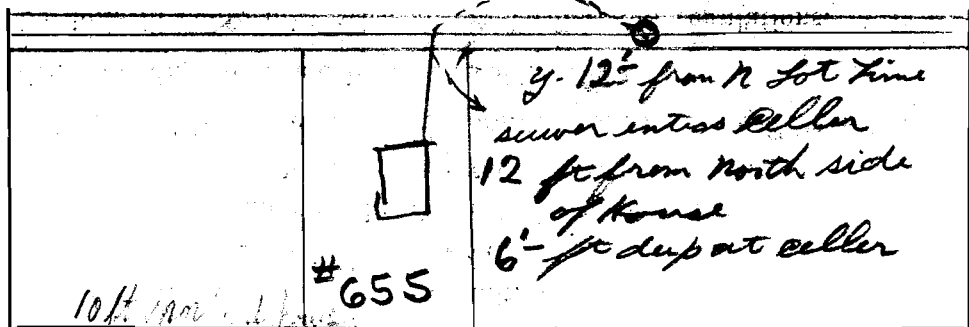

Stambaugh

Westminister Ave.

This plan should show street names and distances to manholes from Y or lateral being connected.

Permit No. 13

Westminster
Sewer District

SEWER CONNECTION

Lot No. 655

Subdivision Broadview Plat

Street Rear of Westminster Ave

Recorded in Sewer Book

Vol. 3, Pg. 38