

SEWER BUILDERS RETURN

I HEREBY CERTIFY that the within connection enters lot at a point 15' from North of Lot line of said lot and was properly made by me on \_\_\_\_\_ day of \_\_\_\_\_


in conformity with the specifications of Sanitary Engineering Department; that the connection was made with the recorded Y branch or connection for said lot without opening or in any way injuring the main sewer; that said connection was laid to a true and proper grade, and constructed of sound and substantial 5" Terracotta sewer pipe, with the joints properly cemented and tight and that the whole was left in clean and good condition.

Measurement used was 5' 0" feet from South M. H. depth of connection at point of tap 9'

Depth of connection at lot line 7' Connection in house made to 8' 6"

Roofwater is (not) conducted under my contract to \_\_\_\_\_

Approved: Geo. R. Snyder  
Licensed Sewer Builder  
W. H. Hynes  
Inspector

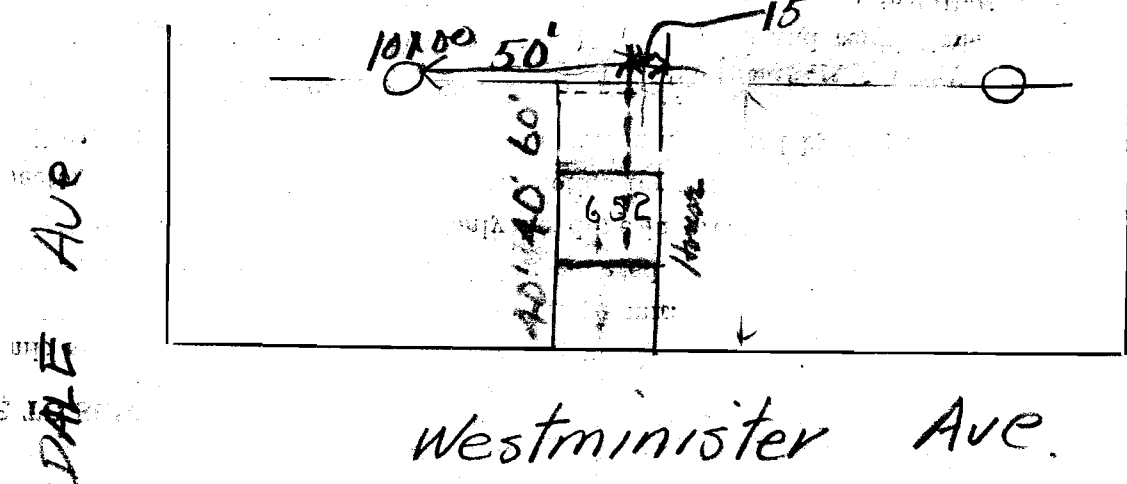

This plan should show street names and distances to manholes from Y or lateral being connected.

Permit No. 14  
Austintown  
Sewer District

SEWER CONNECTION  
Lot No. 657

Subdivision Wickliffe  
Street Pine Hill Road of Westminster Ave

Recorded in Sewer Book  
Vol. 3, Pg. 33