


SEWER BUILDERS RETURN

I HEREBY CERTIFY that the within connection enters lot at a point 17 feet from North line of said lot and was properly made by me on 19 day of Aug 1925 in conformity with the specifications of Sanitary Engineering Department; that the connection was made with the recorded Y branch or connection for said lot without opening or in any way injuring the main sewer; that said connection was laid to a true and proper grade, and constructed of sound and substantial 5 in sewer pipe, with the joints properly cemented and tight and that the whole was left in clean and good condition.

Measurement used was 46" feet from Center Depth of connection at point of tap 7'6"
Depth of connection at lot line 7' Connection in house made to Bath + 2 sinks
Roofwater will be conducted under my contract to To Gutter
Harry M. Womley
Licensed Sewer Builder
Approved [Signature] Inspector

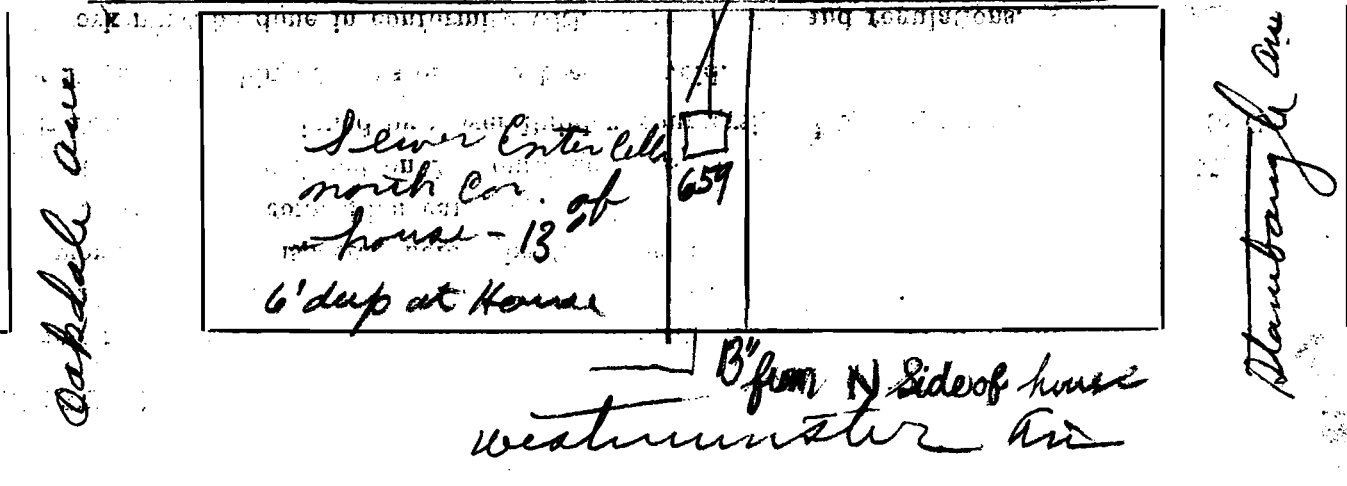

This plan should show street names and distances to manholes from Y or lateral being connected.

Permit No. 15
Sewer District District 10
SEWER CONNECTION
Lot No. 659
Subdivision Michie Bluffs Broadview Plat
Street Rocky Mt Westminster Ave
Recorded in Sewer Book
Vol. 3, Pg. 35