


SEWER BUILDERS RETURN

I HEREBY CERTIFY that the within connection enters lot at a point 6 feet from North line of said lot and was properly made by me on 4th day of Aug. 1925 in conformity with the specifications of Sanitary Engineering Department; that the connection was made with the recorded Y branch or connection for said lot without opening or in any way injuring the main sewer; that said connection was laid to a true and proper grade, and constructed of sound and substantial 5 sewer pipe, with the joints properly cemented and tight and that the whole was left in clean and good condition.

Measurement used was stake feet from _____ Depth of connection at point of tap 11'8"
Depth of connection at lot line 11'8" Connection in house made to Bath + 2 sinks

Roofwater ~~is~~ will be conducted under my contract to gutter
sewer raised 2 ft in first 6 ft from main sewer
Harry M. Wormley
Licensed Sewer Builder

Approved J. B. McCarthey Inspector

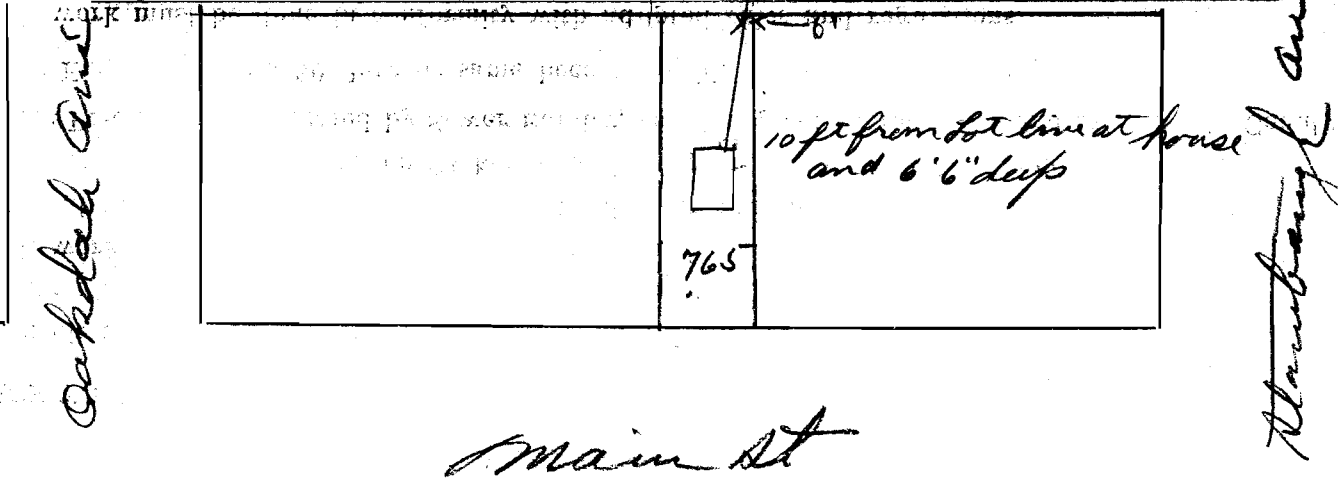

This plan should show street names and distances to manholes from Y or lateral being connected.

Permit No. 16

W. T. ...
Sewer District

SEWER CONNECTION

Lot No. 765

Subdivision Wichiff Blvd

Street Rear of Lot on Main

Recorded in Sewer B

Vol. 3, Pg. 33

FILED
AUG 10 1925
CITY OF ...