


SEWER BUILDERS RETURN

I HEREBY CERTIFY that the within connection enters lot at a point 9 feet FROM NORTH line of said lot and was properly made by me on 21st day of AUG in conformity with the specifications of Sanitary Engineering Department; that the connection was made with the recorded Y branch or connection for said lot without opening or in any way injuring the main sewer; that said connection was laid to a true and proper grade, and constructed of sound and substantial VITRIFIED sewer pipe, with the joints properly cemented and tight and that the whole was left in clean and good condition.

Measurement used was 9 feet from LINE Depth of connection at point of tap 10'
Depth of connection at lot line 9' 6" Connection in house made to STACK
Roofwater is (not) conducted under my contract to REALTY SECURITY CO
MAC DONALD AND MCGONIGAL
Licensed Sewer Builder

Approved B. E. McCarthy Inspector

OAKDALE AVE

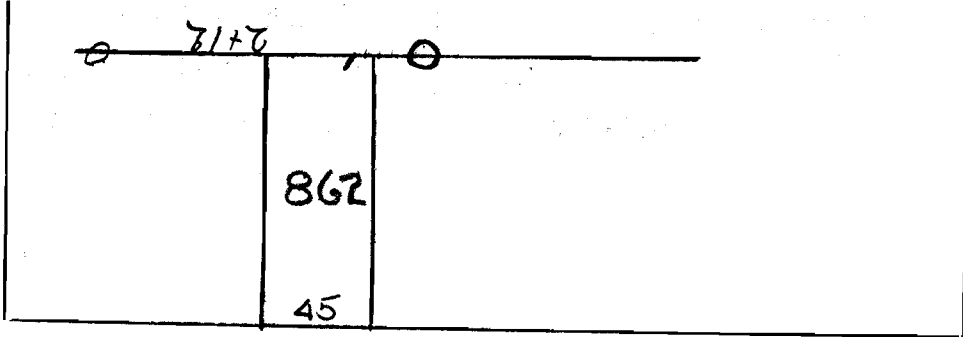

CARNEGIE AVE

This plan should show street names and distances to manholes from Y or lateral being connected.

Permit No. 17
Australe
Sewer District

SEWER CONNECTION

Lot No. 862
Subdivision Wickliffe
Street Carnegie Ave East

Recorded in Sewer Book
Vol. 3, Pg. 29

101
61
10166
101 101
101 101