

SEWER BUILDERS RETURN

I HEREBY CERTIFY that the within connection enters lot at a point 24 feet EVEN

line of said lot and was properly made by me on 21st day of AUG


in conformity with the specifications of Sanitary Engineering Department; that the connection was made with the recorded Y branch or connection for said lot without opening or in any way injuring the main sewer; that said connection was laid to a true and proper grade, and constructed of sound and substantial VITRIFIED sewer pipe, with the joints properly cemented and tight and that the whole was left in clean and good condition.

Measurement used was 24 feet from LINE Depth of connection at point of tap 6'6"

Depth of connection at lot line 6'4" Connection in house made to STACKS

Roofwater ~~will be~~ is (not) conducted under my contract to REALTY SECURITY CO.  
MAC DONALD AND MCGONIGAL  
Licensed Sewer Builder

Approved C. J. McBerth Inspector

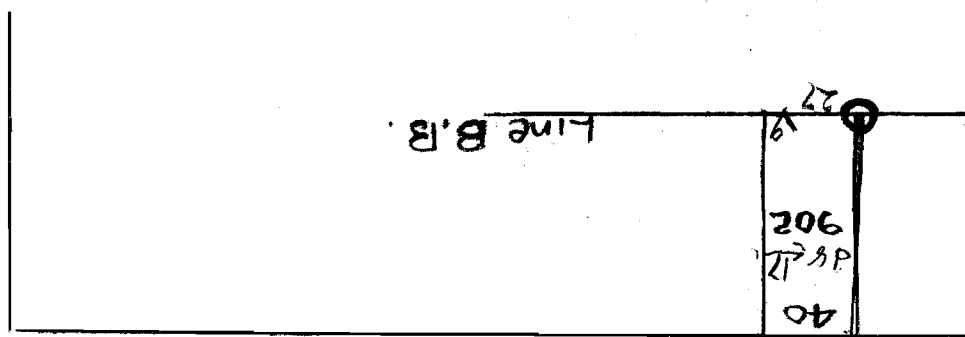

CARNEGIE AVE

WARD AVE

This plan should show street names and distances to manholes from Y or lateral being connected.

Permit No. 18

Quinton  
Sewer District

SEWER CONNECTION

Lot No. 902

Subdivision Wickliffe Ave

Street Carnegie Ave Line B.B.

Recorded in Sewer Book

Vol. 3, Pg. 24

62-  
10166  
1006  
and