


SEWER BUILDERS RETURN

I HEREBY CERTIFY that the within connection enters lot at a point 8' from line of house line of said lot and was properly made by me on 16 day of Aug 1925 in conformity with the specifications of Sanitary Engineering Department; that the connection was made with the recorded Y branch or connection for said lot without opening or in any way injuring the main sewer; that said connection was laid to a true and proper grade, and constructed of sound and substantial 5" sewer pipe, with the joints properly cemented and tight and that the whole was left in clean and good condition.

Measurement used was 5'6" South of M.H. feet from Depth of connection at point of tap 7'6"
Depth of connection at lot line 7'6" Connection in house made to Bath + 2 sinks
Roofwater will be is (not) conducted under my contract to gutter

Harry M. Womley
Licensed Sewer Builder
Approved
Inspector

STAMBAUGH

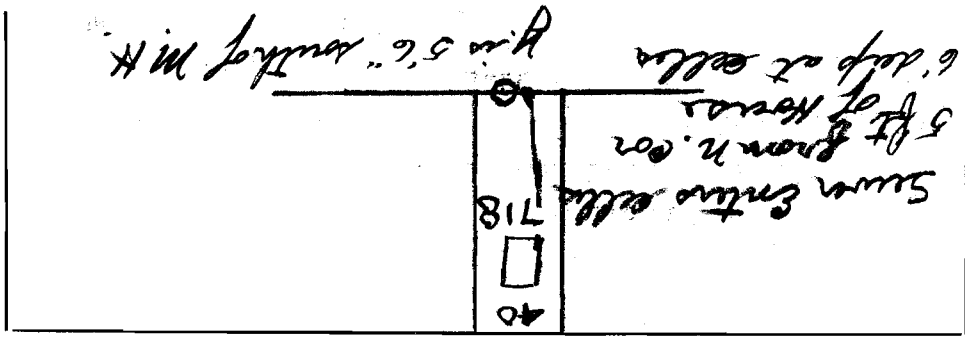

WESTMINISTER AVE.

This plan should show street names and distances to manholes from Y or lateral being connected.

Permit No. 19

Quinton
Sewer District

SEWER CONNECTION

Lot No. 718

Subdivision Wickliffe

Street Linn II

Recorded in Sewer Book

Vol. 3, Pg. 33

DGE-
1925
100
100
100
100