

SEWER BUILDERS RETURN

I HEREBY CERTIFY that the within connection enters lot at a point 21' feet NORTH line of said lot and was properly made by me on 24th day of SEPT. in conformity with the specifications of Sanitary Engineering Department; that the connection was made with the recorded Y branch or connection for said lot without opening or in any way injuring the main sewer; that said connection was laid to a true and proper grade, and constructed of sound and substantial 5" sewer pipe, with the joints properly cemented and tight and that the whole was left in clean and good condition.


Measurement used was 6.9 feet from South M.H. Depth of connection at point of tap 6'6" Depth of connection at lot line 6'6" Connection in house made to HOUSE SEWER

Roofwater is (not) conducted under my contract to

MAC DONALD M. GONIGAL BY J.A.M.
Licensed Sewer Builder

Approved: [Signature]
Inspector

WICKLIFFE BLVD

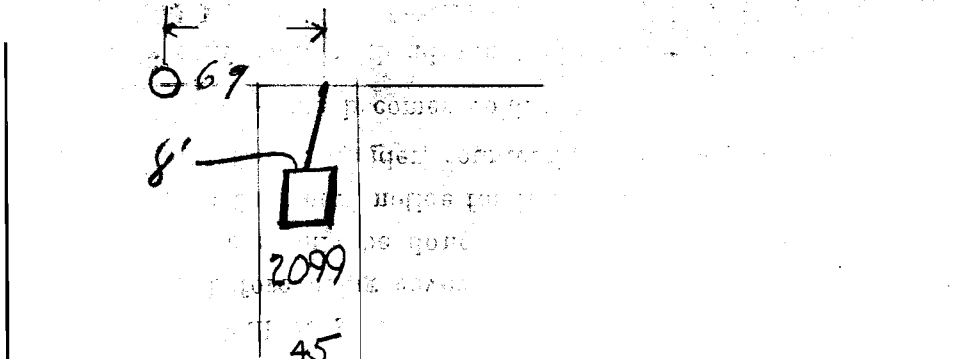

EDGEHILL

This plan should show street names and distances to manholes from Y or lateral being connected.

Permit No. 30

[Signature]
Sewer District

SEWER CONNECTION

Lot No. 2099 G.L. #9

Subdivision Wickliffe Blvd

Street Edgehill Ave (South M.H.)

Recorded in Sewer Book

Vol. 3, Pg. 42