

SEWER BUILDERS RETURN

I HEREBY CERTIFY that the within connection enters lot at a point 2 feet West
8/25 day of 1925

line of said lot and was properly made by me on 5 feet sewer pipe, with the joints properly cemented and tight and that the whole was left in clean and good condition.


Measurement used was 67 feet from M.H. Depth of connection at point of tap 5' 6"

Found flake

Depth of connection at lot line 3' 6" Connection in house made to 4" Stack - Celler Drain

Roofwater ~~is~~ will be conducted under my contract to Street by separate sewer line

Approved C. H. Richards Licensed Sewer Builder
W. O. McArthur Inspector

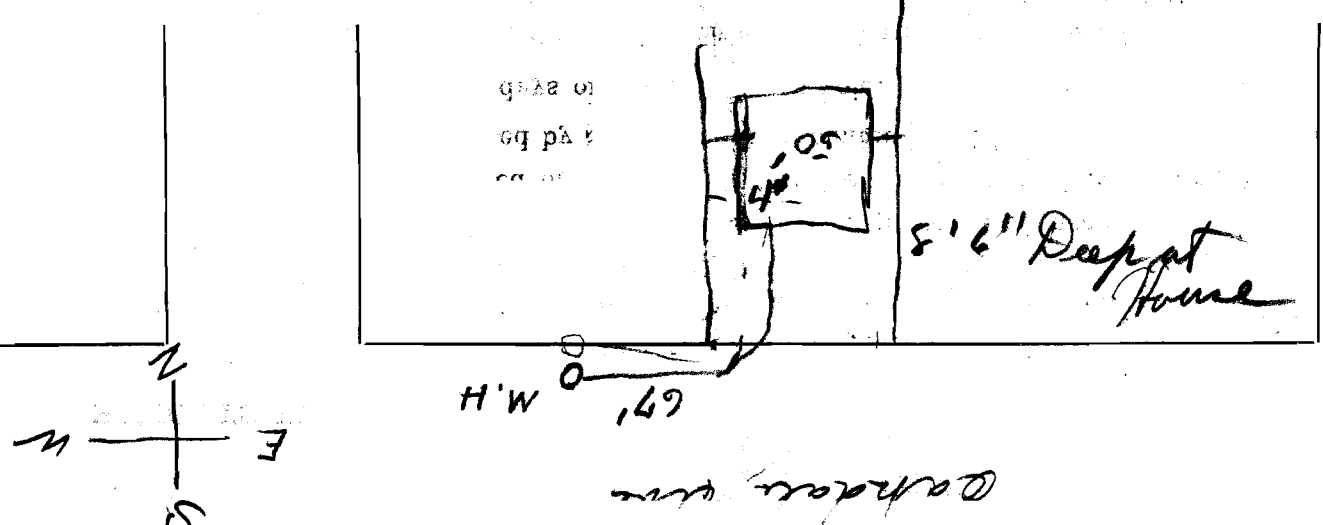

This plan should show street names and distances to manholes from Y or lateral being connected.

Permit No. 24
Austin Town
Sewer District

SEWER CONNECTION

Lot No. 9
Subdivision PA Andrews
Street Oakdale Ave

Recorded in Sewer Book

Vol. 3, Pg. 17

W. Lloyd Stanley
Physician sewer map
Ex. 101-8