


SEWER BUILDERS RETURN

I HEREBY CERTIFY that the within connection enters lot at a point 6 feet from
South corner of lot said lot and was properly made by me on _____ day of _____
in conformity with the specifications of Sanitary Engineering Department; that the connection was made with the recorded Y
branch or connection for said lot without opening or in any way injuring the main sewer; that said connection was laid to a
true and proper grade, and constructed of sound and substantial _____ sewer pipe, with the joints properly
cemented and tight and that the whole was left in clean and good condition.

Measurement used was 52 feet from Station 11500 Depth of connection at point of tap 10'
Depth of connection at lot line 7'6" Connection in house made to _____
Roofwater will be _____
is (not) _____ conducted under my contract to _____

Mac Squalof - M.S. Squalof
Mac Squalof Licensed Sewer Builder
Approved W. Hynes Inspector

Oakdale Ave.

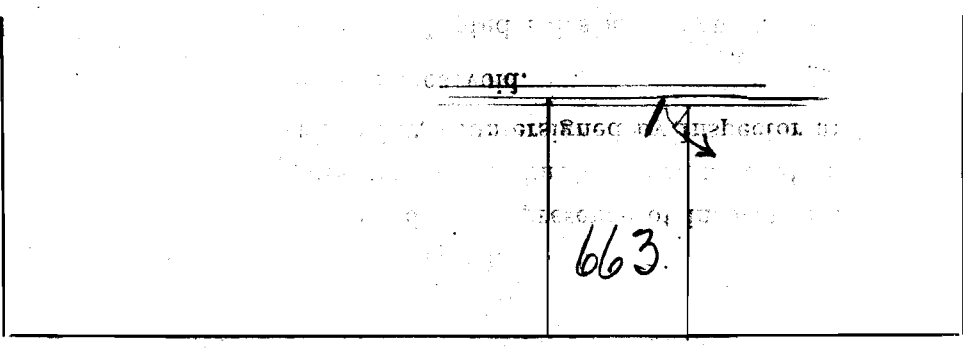

Stambridge Ave.

Westminster Ave.

This plan should show street names and distances to manholes from Y or lateral being connected.

Permit No. 25
Sewer District _____

SEWER CONNECTION

Lot No. 663
Subdivision Wickliffe Plat
Street Rear of Westminster Ave

Recorded in Sewer Book

Vol. 3, Pg. 38