


SEWER BUILDERS RETURN

I HEREBY CERTIFY that the within connection enters lot at a point 8 feet from North
line of Durd line of said lot and was properly made by me on Oct 16 day of
in conformity with the specifications of Sanitary Engineering Department; that the connection was made with the recorded Y
branch or connection for said lot without opening or in any way injuring the main sewer; that said connection was laid to a
true and proper grade, and constructed of sound and substantial 5" sewer pipe, with the joints properly
cemented and tight and that the whole was left in clean and good condition.

Measurement used was 125" feet from MH Depth of connection at point of tap 14"
Depth of connection at lot line 8' Connection in house made to Bath + 2 sinks
Roofwater will be gutter
is (not) conducted under my contract to Harry M. Womley
Licensed Sewer Builder

Approved [Signature]
Inspector

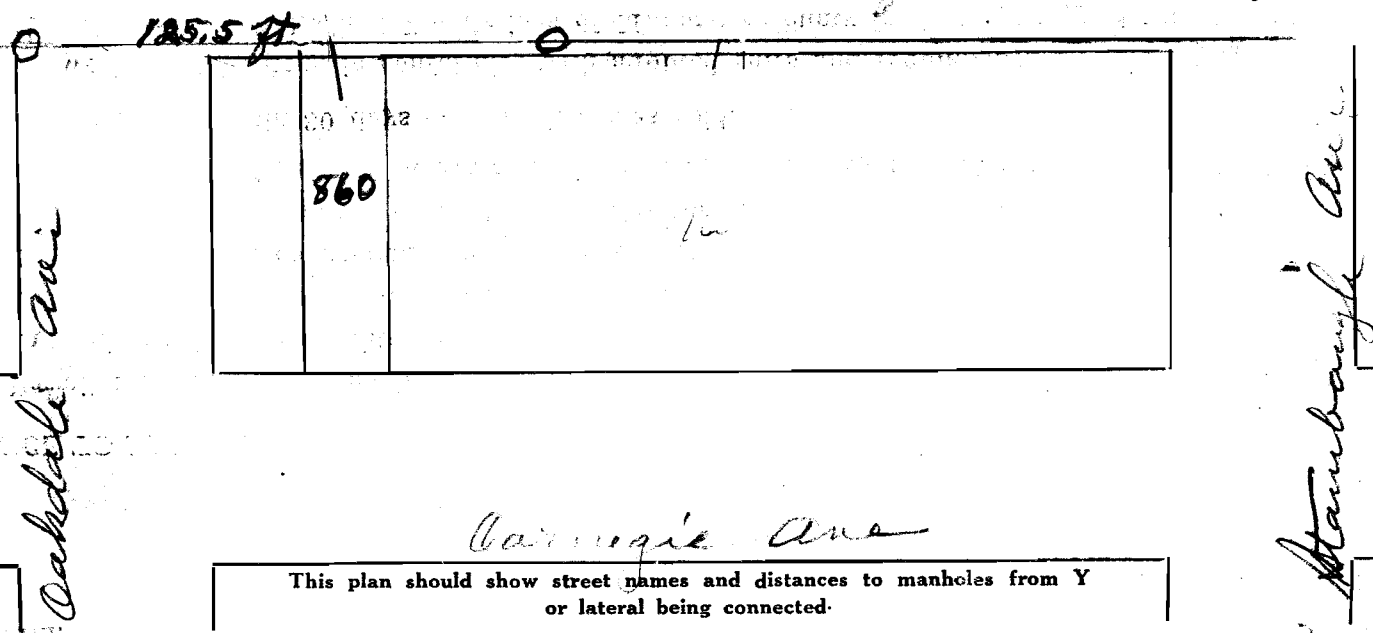

Permit No. 26
Aurinton
Sewer District

SEWER CONNECTION
Lot No. 860
Subdivision Broadview Pkt
Street Rear of Lot on Carnegie Ave
Line 89

Recorded in Sewer Book
Vol. 13, Pg. 29

FOR THE
RECORD