


SEWER BUILDERS RETURN

I HEREBY CERTIFY that the within connection enters lot at a point 10' feet From North
16th line of said lot and was properly made by me on 16th day of SEPT 1925
in conformity with the specifications of Sanitary Engineering Department; that the connection was made with the recorded Y
branch or connection for said lot without opening or in any way injuring the main sewer; that said connection was laid to a
true and proper grade, and constructed of sound and substantial 5" sewer pipe, with the joints properly
cemented and tight and that the whole was left in clean and good condition.

Measurement used was 14' feet from S-M.H. Depth of connection at point of tap 8'6"
Depth of connection at lot line 8'6" Connection in house made to HOUSE SEWER.
Roofwater ~~will be~~ is (not) conducted under my contract to SEWER.

Approved: Mae Donald McJung
By H. M. [unclear] Licensed Sewer Builder
W. Hynes Inspector

1264
1200
14

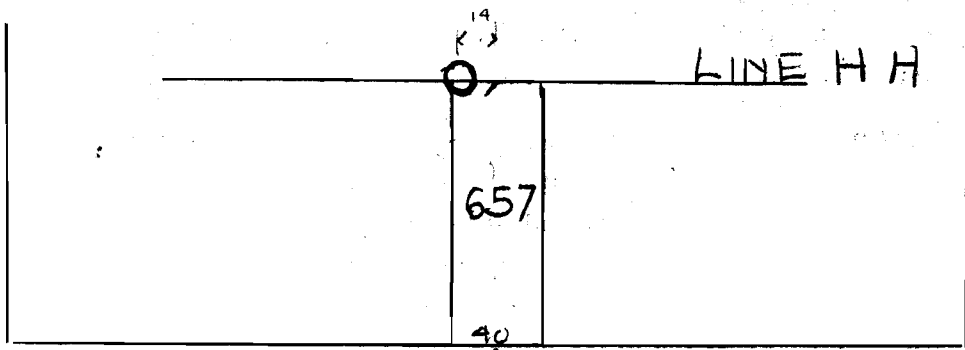

WESTMINISTER AVE

This plan should show street names and distances to manholes from Y or lateral being connected.

Permit No. 39
Westminster Ave
Sewer District
SEWER CONNECTION
Lot No. 657
Subdivision Wickliffe Plat
Street Westminster Lane H. H.
Recorded in Sewer Book
Vol. 3, Pg. 38

FILED
IN OFFICE
OF THE
CITY ENGINEER
AT
ST. LOUIS, MO.
SEP 21 1925