


SEWER BUILDERS RETURN

I HEREBY CERTIFY that the within connection enters lot at a point 11 feet North line of said lot and was properly made by me on Nov 1 day of Nov in conformity with the specifications of Sanitary Engineering Department; that the connection was made with the recorded Y branch or connection for said lot without opening or in any way injuring the main sewer; that said connection was laid to a true and proper grade, and constructed of sound and substantial 5" sewer pipe, with the joints properly cemented and tight and that the whole was left in clean and good condition.

Measurement used was _____ feet from _____ Depth of connection at point of tap 9
Depth of connection at lot line 9 Connection in house made to Bath
Roofwater ~~will be~~ conducted under my contract to curb

A J Scott
Licensed Sewer Builder
Approved W Hynes
Inspector

OAKDALE AVE.

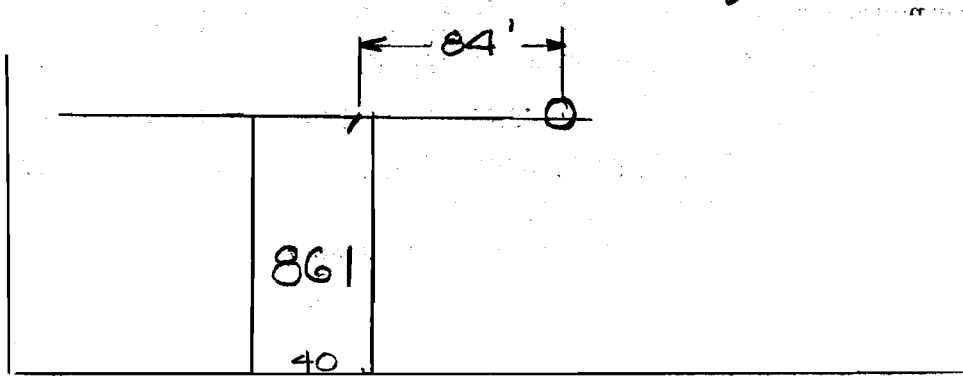

CARNEGIE AVE.

This plan should show street names and distances to manholes from Y or lateral being connected.

Permit No. 31
Assistant
Sewer District
SEWER CONNECTION
Lot No. 861
Subdivision Wieblyffe Addition
Street Rear of Carnegie
Recorded in Sewer Book
Vol. 3, Pg. 29

180
7/16