

SEWER BUILDERS RETURN


I HEREBY CERTIFY that the within connection enters lot at a point 8 feet from North line of said lot and was properly made by me on May 10 day of May in conformity with the specifications of Sanitary Engineering Department; that the connection was made with the recorded Y branch or connection for said lot without opening or in any way injuring the main sewer; that said connection was laid to a true and proper grade, and constructed of sound and substantial 5 sewer pipe, with the joints properly cemented and tight and that the whole was left in clean and good condition.

Measurement used was 15.7 feet from M.H. North Depth of connection at point of tap 9'6"
 Depth of connection at lot line 9' Connection in house made to Stack Below Drain Tank
 Roofwater ~~will be~~ is (not) conducted under my contract to _____

 Licensed Sewer Builder
 Approved J. S. Perkins
 Inspector

131
 006
 1501

POSTONAC AVE

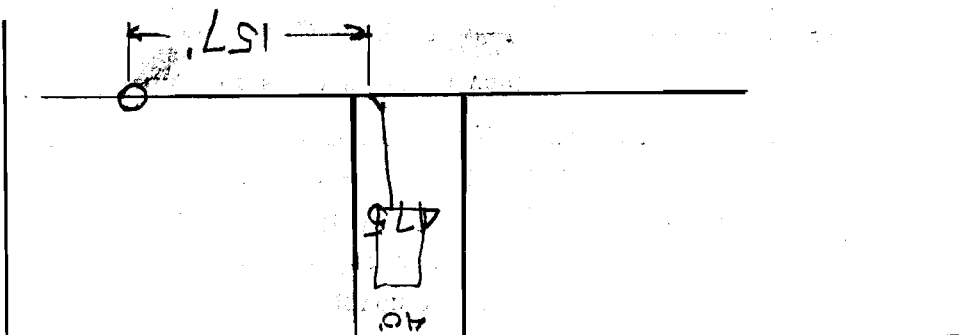

HUNTMERE RD.

ROSEMONT AVE

This plan should show street names and distances to manholes from Y or lateral being connected.

Permit No. 34

Arlington
 Sewer District

SEWER CONNECTION

Lot No. 475

Subdivision Wickliffe

Street Rosemont Ave

Recorded in Sewer Book

Vol. 3, Pg. 126