


SEWER BUILDERS RETURN

I HEREBY CERTIFY that the within connection enters lot at a point 10' feet 4" North line of said lot and was properly made by me on July 27 day of July in conformity with the specifications of Sanitary Engineering Department; that the connection was made with the recorded Y branch or connection for said lot without opening or in any way injuring the main sewer; that said connection was laid to a true and proper grade, and constructed of sound and substantial 6" sewer pipe, with the joints properly cemented and tight and that the whole was left in clean and good condition.

Measurement used was 56' feet from MH-N Depth of connection at point of tap 8'6"
 Depth of connection at lot line 8' Connection in house made to 3-3-W8 Drain
 Roofwater will be is (not) conducted under my contract to _____

Approved E. H. Erhardt
 Licensed Sewer Builder
 Inspector

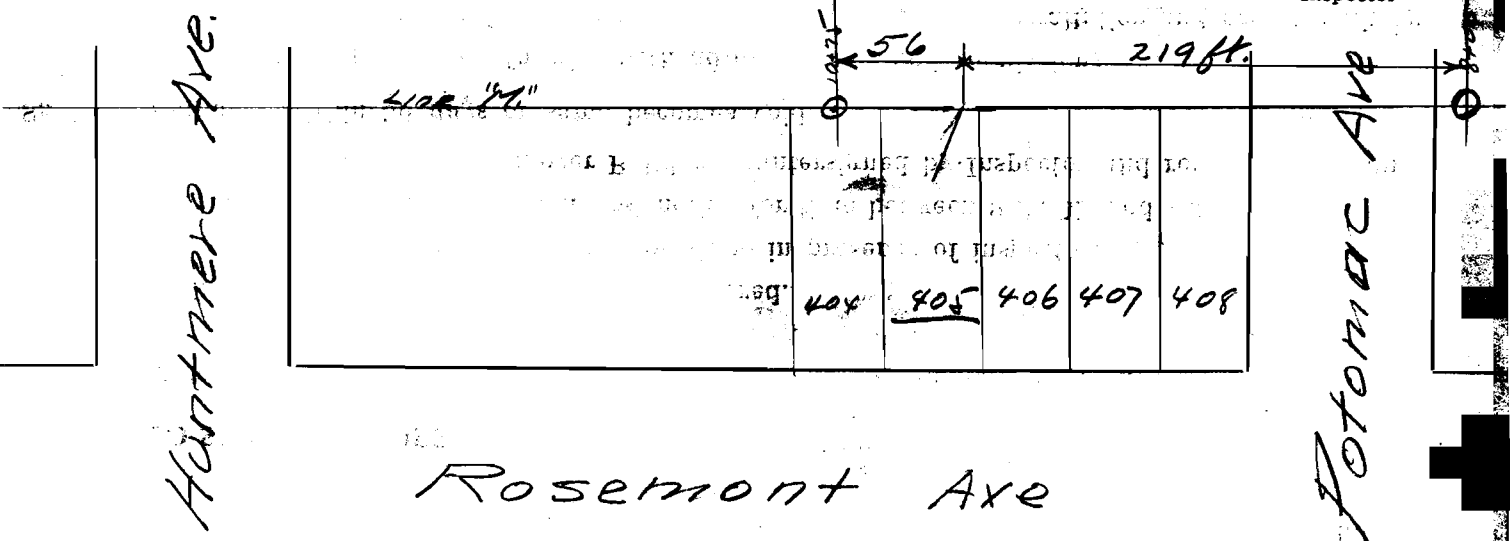

This plan should show street names and distances to manholes from Y or lateral being connected.

Permit No. 35
 Sewer District Quantico
 SEWER CONNECTION
 Lot No. 405
 Subdivision Whelple Parkgate
Sub-Division
 Street Rosemont
 Recorded in Sewer Book
 Vol. 3, Pg. 132