


SEWER BUILDERS RETURN

I HEREBY CERTIFY that the within connection enters lot at a point 11 feet North line of said lot and was properly made by me on 27 day of July in conformity with the specifications of Sanitary Engineering Department; that the connection was made with the recorded Y branch or connection for said lot without opening or in any way injuring the main sewer; that said connection was laid to a true and proper grade, and constructed of sound and substantial 5" sewer pipe, with the joints properly cemented and tight and that the whole was left in clean and good condition.

Measurement used was 11' 6" feet from M.H. - 8 Depth of connection at point of tap 8'
 Depth of connection at lot line 7' 6" Connection in house made to Stack into Drain
 Roofwater ~~is~~ will be conducted under my contract to Street
E. H. Richard
 Licensed Sewer Builder

Approved Hynes Inspector Huntmore

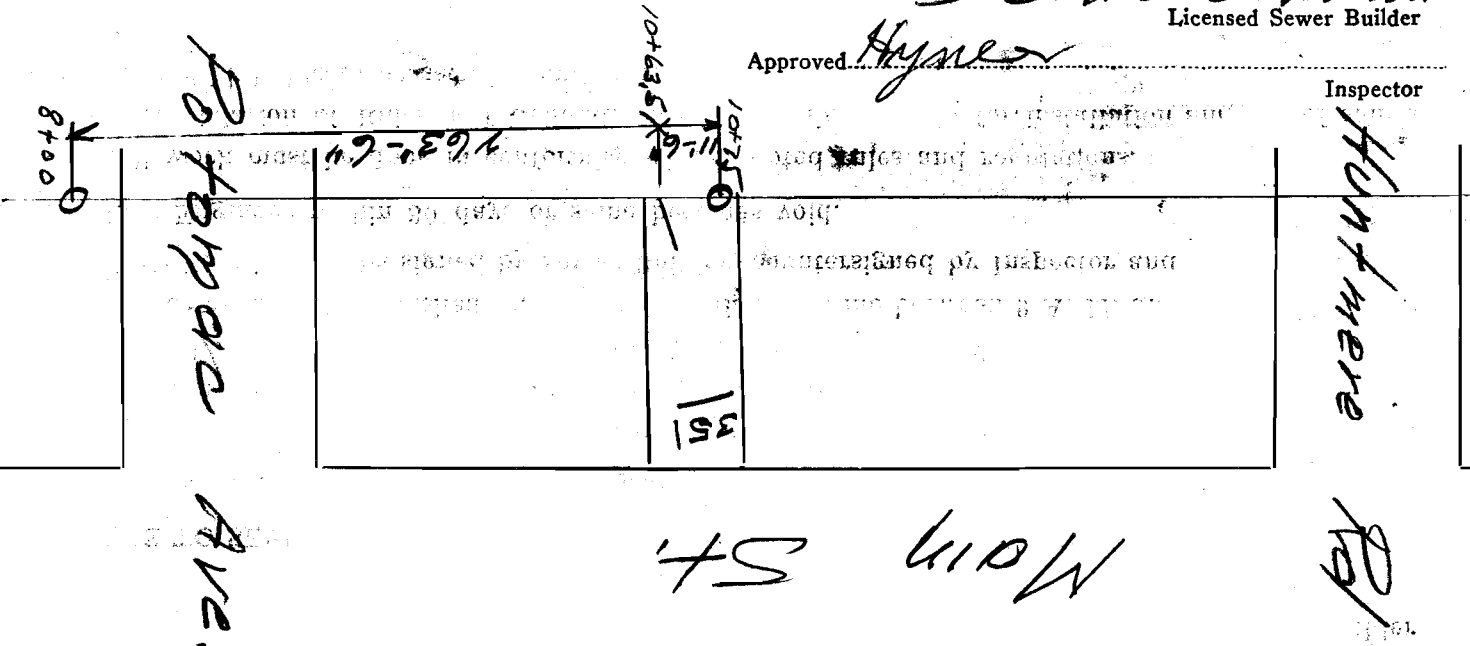

This plan should show street names and distances to manholes from Y or lateral being connected.

Permit No. 37
Quincy
 Sewer District

SEWER CONNECTION

Lot No. 351
 Subdivision Wickville
Part gate, Dub Du
 Street Main St.

Recorded in Sewer Book
 Vol. 3, Pg. 122