

SEWER BUILDERS RETURN

I HEREBY CERTIFY that the within connection enters lot at a point 12' feet from the line of said lot and was properly made by me on _____ day of _____ in conformity with the specifications of Sanitary Engineering Department; that the connection was made with the recorded Y branch or connection for said lot without opening or in any way injuring the main sewer; that said connection was laid to a true and proper grade, and constructed of sound and substantial _____ sewer pipe, with the joints properly cemented and tight and that the whole was left in clean and good condition.


Measurement used was 103 feet from MH Depth of connection at point of tap 7'
Depth of connection at lot line 5'6" Connection in house made to _____
Roofwater will be is (not) conducted under my contract to _____

E. H. Ehardt
Licensed Sewer Builder

Approved Hyne

Inspector

Hatmere Rd

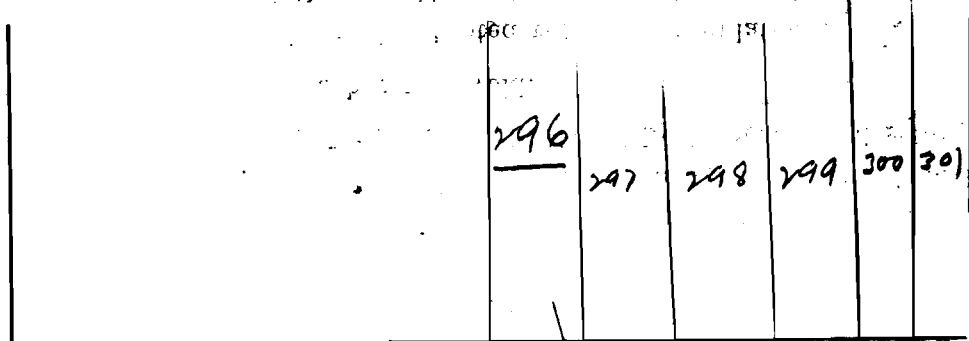

Potomac Ave.

DEB

Main St.

This plan should show street names and distances to manholes from Y or lateral being connected.

Permit No. 39

Washington
Sewer District

SEWER CONNECTION

Lot No. 296

Subdivision Wisc. Bluffs
Bar. Gate / Bar. div.
Street Main St.

Recorded in Sewer Book

Vol. 3, Pg. 118