


SEWER BUILDERS RETURN

I HEREBY CERTIFY that the within connection enters lot at a point 9 feet NORTH line of said lot and was properly made by me on 27 day of July in conformity with the specifications of Sanitary Engineering Department; that the connection was made with the recorded Y branch or connection for said lot without opening or in any way injuring the main sewer; that said connection was laid to a true and proper grade, and constructed of sound and substantial 5" sewer pipe, with the joints properly cemented and tight and that the whole was left in clean and good condition.

Measurement used was 166 feet from MH-3 Depth of connection at point of tap 8'  
 Depth of connection at lot line 7'6" Connection in house made to Sink Stack Drain  
 Roofwater will be conducted under my contract to to Street  
E. H. Erhardt  
 Licensed Sewer Builder

Approved Hynes Inspector

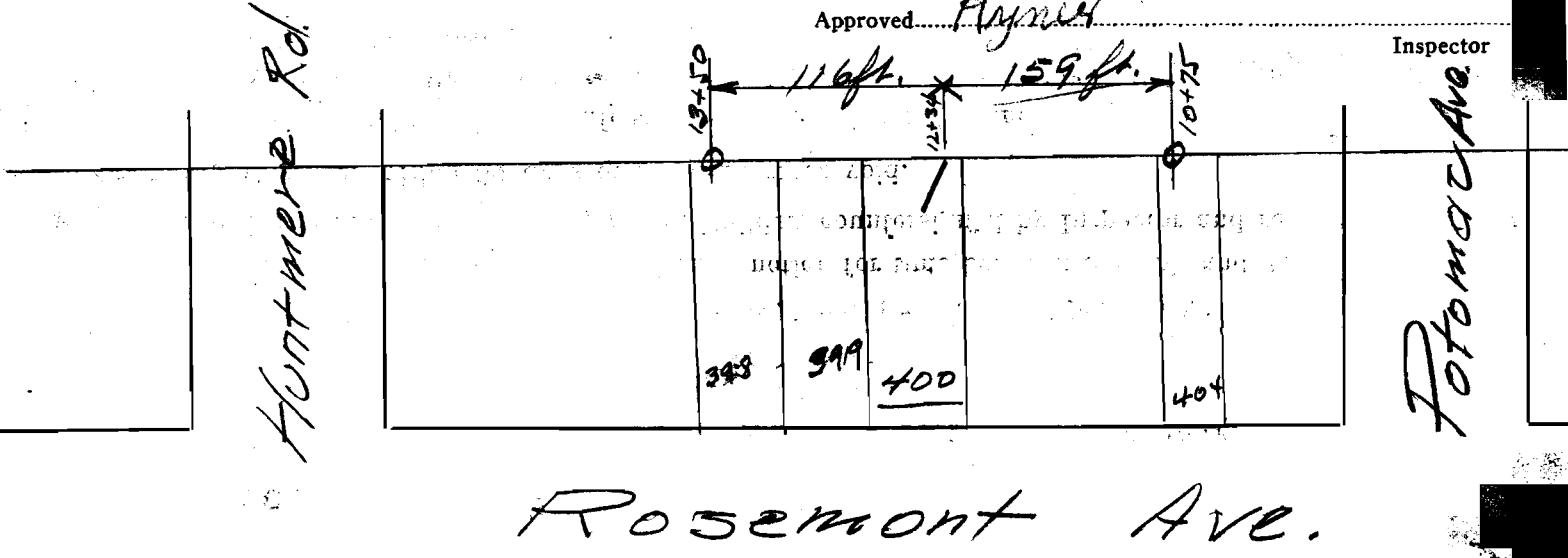

This plan should show street names and distances to manholes from Y or lateral being connected.

Permit No. 41

Quinton  
 Sewer District

SEWER CONNECTION

Lot No. 400

Subdivision Whitcliffe  
Parkgate Sub-div  
 Street Rosemont

Recorded in Sewer Book

Vol. 3, Pg. 133

NO RECORD  
 RECORD  
 RECORD