

**SEWER BUILDERS RETURN**


I HEREBY CERTIFY that the within connection enters lot at a point.....feet.....  
 .....line of said lot and was properly made by me on.....day of.....  
 in conformity with the specifications of Sanitary Engineering Department; that the connection was made with the recorded Y  
 branch or connection for said lot without opening or in any way injuring the main sewer; that said connection was laid to a  
 true and proper grade, and constructed of sound and substantial.....sewer pipe, with the joints properly  
 cemented and tight and that the whole was left in clean and good condition.

Measurement used was.....feet from.....Depth of connection at point of tap.....  
 Depth of connection at lot line..... Connection in house made to.....  
 Roofwater will be conducted under my contract to.....  
 is (not)

Licensed Sewer Builder  
 Approved.....  
 Inspector

*POTOMAC*

*HUNTING*

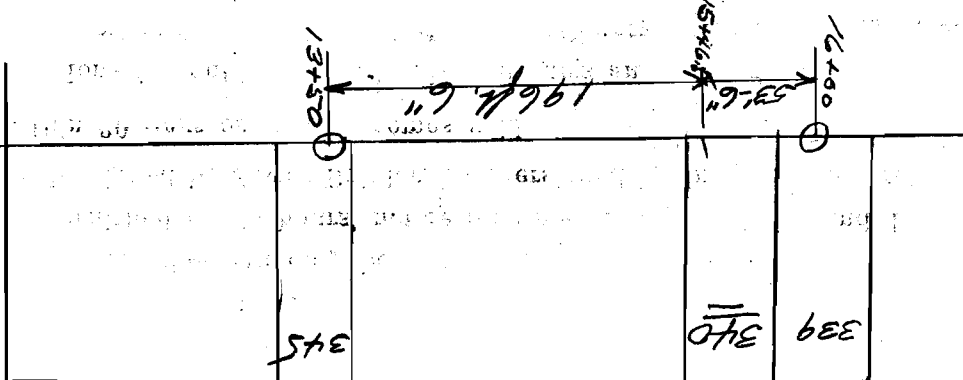

*Main St.*

This plan should show street names and distances to manholes from Y  
 or lateral being connected.

*Permit No. 1422*  
 Sewer District  
*Quentin...*

**SEWER CONNECTION**

Lot No. *340*  
 Subdivision *Edie...*  
 Street *Main*

Recorded in Sewer Book

Vol....., Pg.....

*[Handwritten signature]*