


SEWER BUILDERS RETURN

I HEREBY CERTIFY that the within connection enters lot at a point 7' feet NE line of said lot and was properly made by me on May 14 day of in conformity with the specifications of Sanitary Engineering Department; that the connection was made with the recorded Y branch or connection for said lot without opening or in any way injuring the main sewer; that said connection was laid to a true and proper grade, and constructed of sound and substantial 5' sewer pipe, with the joints properly cemented and tight and that the whole was left in clean and good condition.

Measurement used was 47'6" feet from M.H. - S Depth of connection at point of tap 5'6" Depth of connection at lot line 5' Connection in house made to B.R., K.S. & C. Drain Roofwater is (not) conducted under my contract to ground

E. H. Ehardt
Licensed Sewer Builder
Approved J. G. Perkins
Inspector

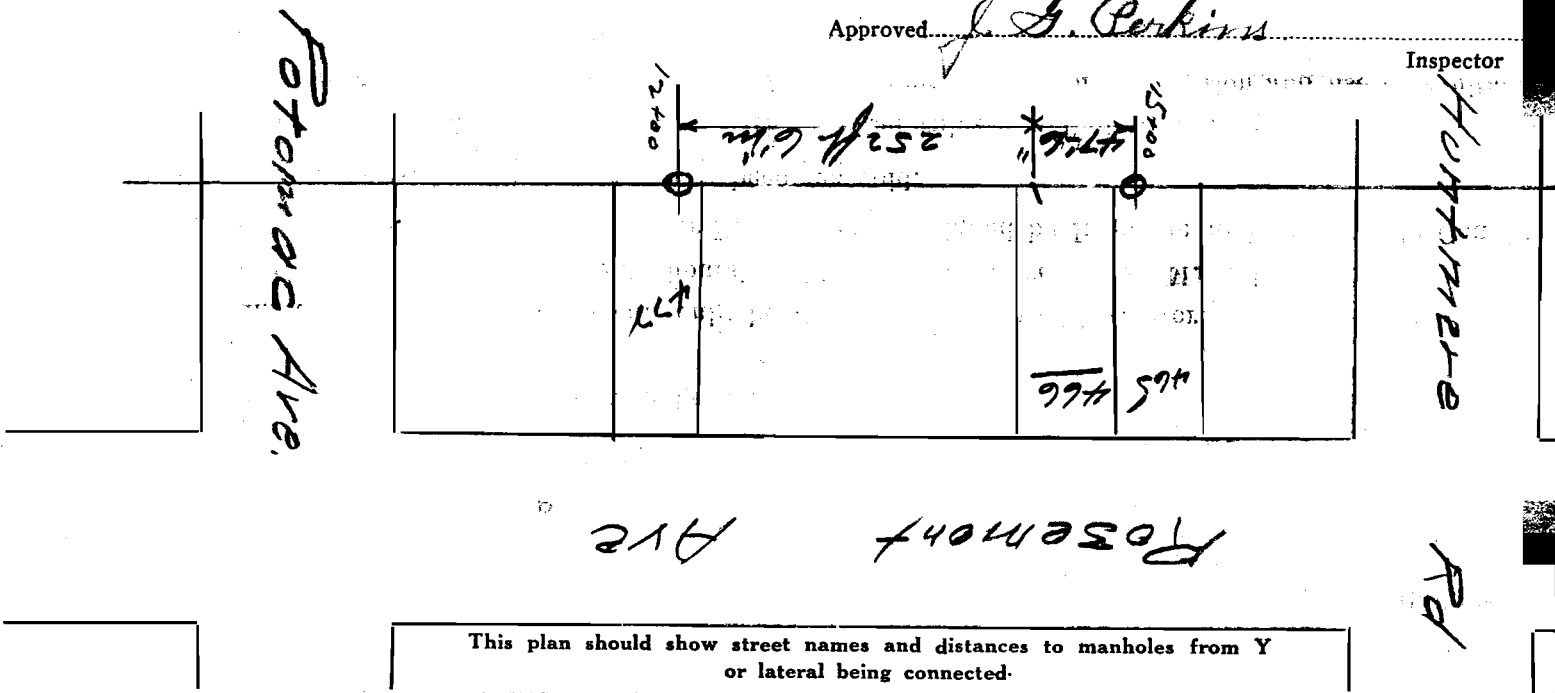

Permit No. 43

Washington
Sewer District

SEWER CONNECTION

Lot No. 466

Subdivision Wickville
Parkgate Addition
Street Rosemont

Recorded in Sewer Book

Vol. 3, Pg. 136

RD