


SEWER BUILDERS RETURN

I HEREBY CERTIFY that the within connection enters lot at a point $14\frac{1}{2}$ feet SOUTH of NORTH line of said lot and was properly made by me on 9th day of JUNE, 1926 in conformity with the specifications of Sanitary Engineering Department; that the connection was made with the recorded Y branch or connection for said lot without opening or in any way injuring the main sewer; that said connection was laid to a true and proper grade, and constructed of sound and substantial 5" vitrified sewer pipe, with the joints properly cemented and tight and that the whole was left in clean and good condition.

Measurement used was 100 feet from south M.H. Depth of connection at point of tap $9\frac{1}{2}$ Depth of connection at lot line $7\frac{1}{2}$ Connection in house made to HOUSE-draw Roofwater ~~will be~~ is (not) conducted under my contract to surface

Harry M. Wormley
Licensed Sewer Builder
Approved 6-9-26. Ray B. Bachtell
Inspector

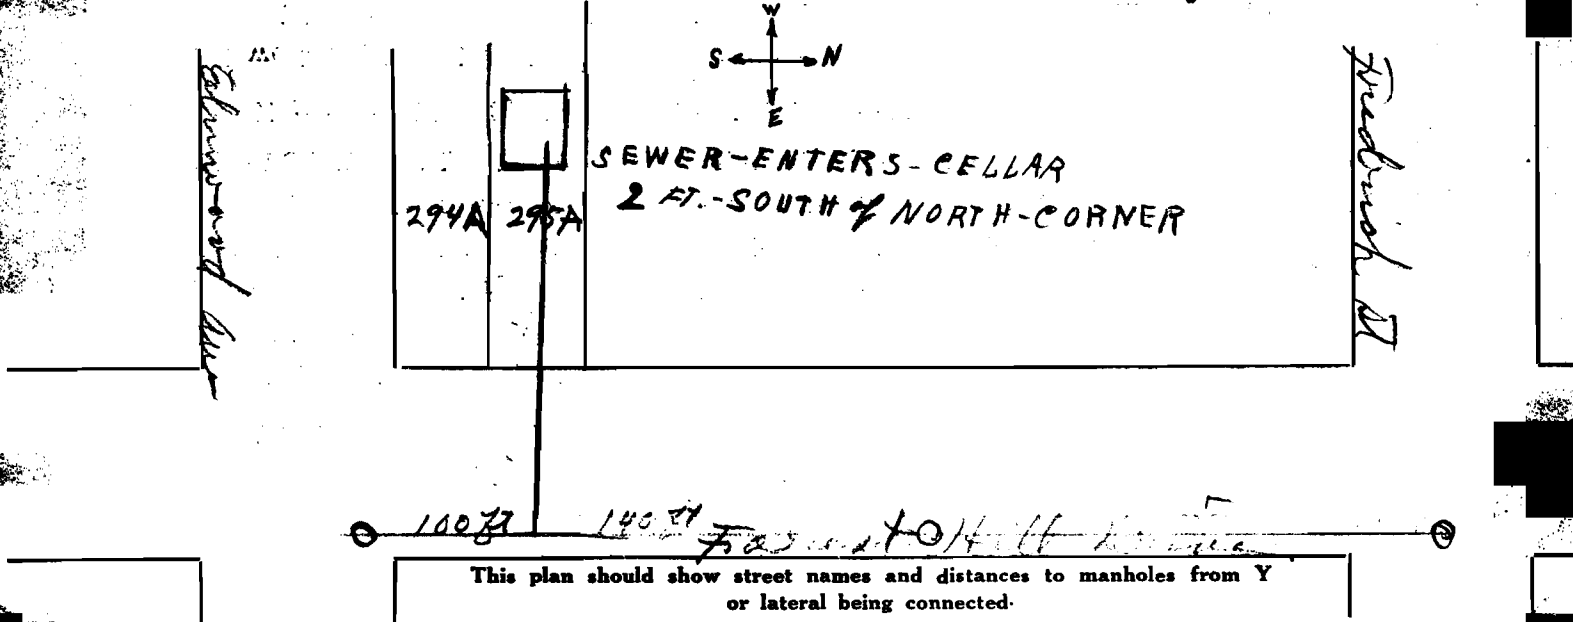

Permit No. 46

Quintanilla
Sewer District

SEWER CONNECTION

Lot No. 295A

Subdivision Wickliffe Annex

Street Elmwood

Recorded in Sewer Book

Vol. 5, Pg. 135

2490
2390
100