


SEWER BUILDERS RETURN

I HEREBY CERTIFY that the within connection enters lot at a point 10' feet 10" North line of said lot and was properly made by me on July 27 day of July in conformity with the specifications of Sanitary Engineering Department, that the connection was made with the recorded Y branch or connection for said lot without opening or in any way injuring the main sewer; that said connection was laid to a true and proper grade, and constructed of sound and substantial 5" sewer pipe, with the joints properly cemented and tight and that the whole was left in clean and good condition.

Measurement used was 33 feet from M.H.-N Depth of connection at point of tap 7' 2"
Depth of connection at lot line 7' Connection in house made to Stack under C. Drain
Roofwater will be 100% conducted under my contract to to Street
E. H. Ehrhardt
Licensed Sewer Builder

Approved Hynes Inspector

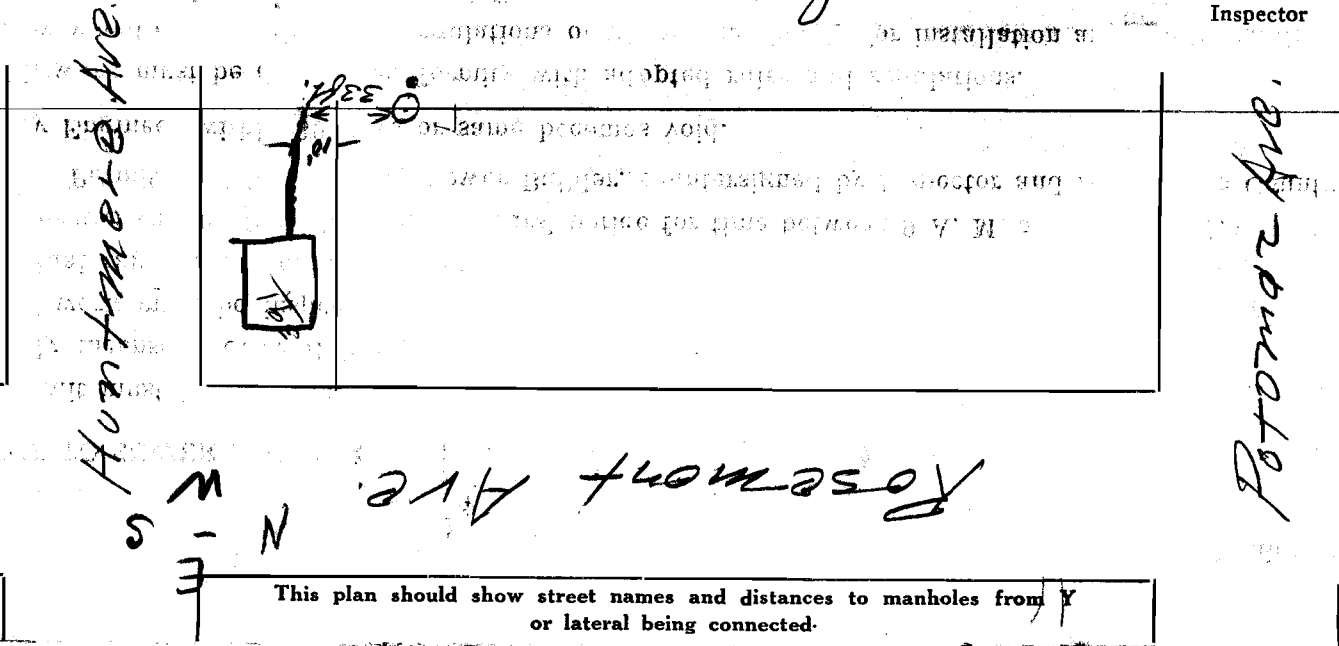

Permit No. 51

Sewer District

SEWER CONNECTION

Lot No. 391

Subdivision Pargo to Wickliff all other

Street Between Rosemont & Main

Recorded in Sewer Book

Vol. 3, Pg. 123