


SEWER BUILDERS RETURN

I HEREBY CERTIFY that the within connection enters lot at a point 5' feet west of East line of said lot and was properly made by me on 28th day of July, 1926. in conformity with the specifications of Sanitary Engineering Department; that the connection was made with the recorded Y branch or connection for said lot without opening or in any way injuring the main sewer; that said connection was laid to a true and proper grade, and constructed of sound and substantial 5" Glaze sewer pipe, with the joints properly cemented and tight and that the whole was left in clean and good condition.

Measurement used was 143' feet from east M.H. Depth of connection at point of tap 8 ft Depth of connection at lot line 7' Connection in house made to house drain Roofwater will be is (not) conducted under my contract to \_\_\_\_\_

J Frank Murray  
Licensed Sewer Builder  
Approved 7-28-26 Ray B. Burtell  
8-5-26 Inspector

6ft deep entering house

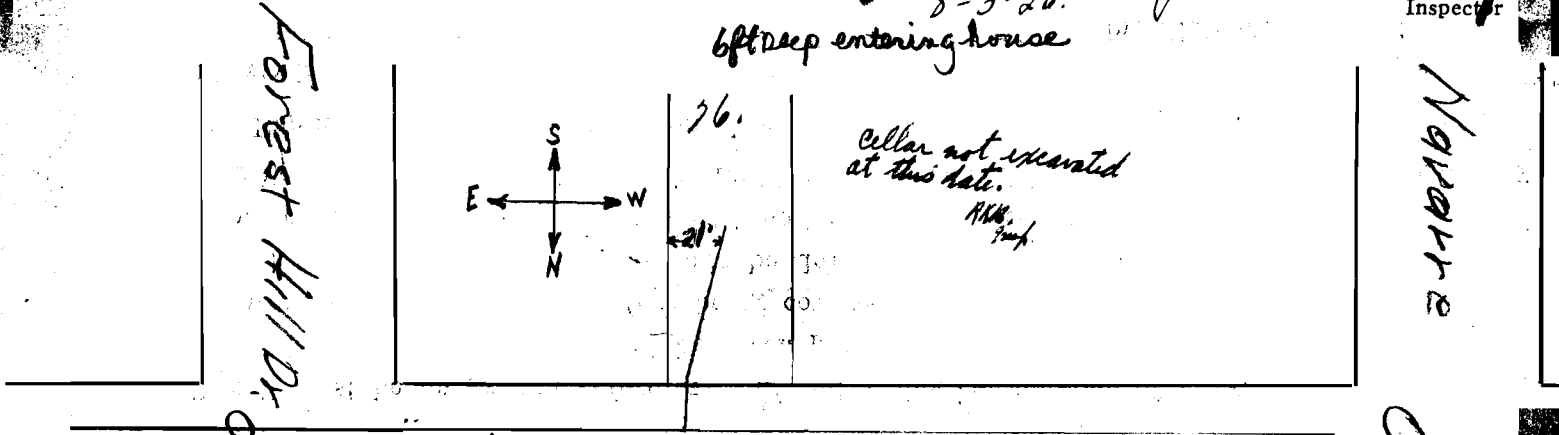

This plan should show street names and distances to manholes from Y or lateral being connected.

Permit No. 53  
Quintanar  
Sewer District

SEWER CONNECTION

Lot No. 76  
Subdivision Wickliffe  
Street Wickliffe Blvd  
Recorded in Sewer Book  
Vol. 3, Pg. 4