


SEWER BUILDERS RETURN

I HEREBY CERTIFY that the within connection enters lot at a point 13' 9" feet south of north line of said lot and was properly made by me on 7th day of April, 1927 in conformity with the specifications of Sanitary Engineering Department; that the connection was made with the recorded Y branch or connection for said lot without opening or in any way injuring the main sewer; that said connection was laid to a true and proper grade, and constructed of sound and substantial 5" vitrified sewer pipe, with the joints properly cemented and tight and that the whole was left in clean and good condition.

Measurement used was 120' feet from North M.H. Depth of connection at point of tap 7'
Depth of connection at lot line 7' Connection in house made to house drain
Roofwater ~~will be~~ is (not) conducted under my contract to E. V. Bredeman

E. V. Bredeman
Licensed Sewer Builder
Approved 4-7-27 Ray W. Bachtell
Inspector

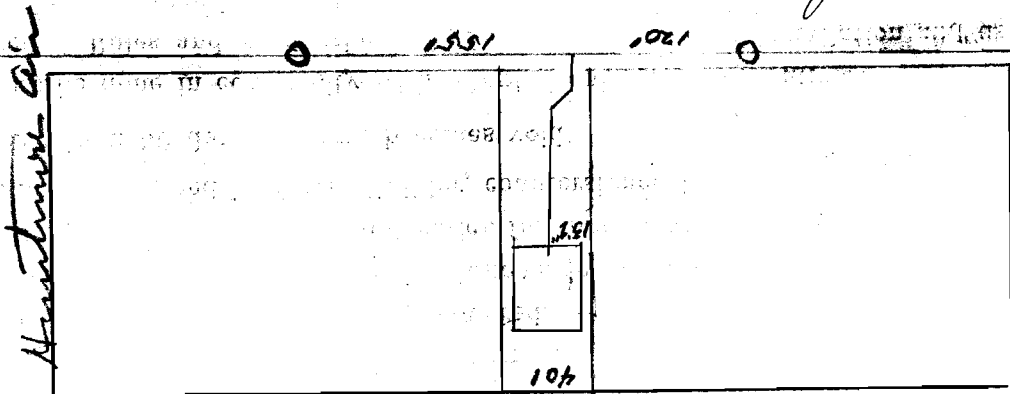

This plan should show street names and distances to manholes from Y or lateral being connected.

Duplicate ✓

Permit No. 59

Austintown
Sewer District

SEWER CONNECTION

Lot No. 401

Subdivision Wickliffe-Pargate

Street Between Rowmont & Main

Recorded in Sewer Book

Vol. 3, Pg. 122