


SEWER BUILDERS RETURN

I HEREBY CERTIFY that the within connection enters lot at a point 9' feet south of north line of said lot and was properly made by me on 12<sup>th</sup> day of April, 1927 in conformity with the specifications of Sanitary Engineering Department; that the connection was made with the recorded Y branch or connection for said lot without opening or in any way injuring the main sewer; that said connection was laid to a true and proper grade, and constructed of sound and substantial 5" vitrified sewer pipe, with the joints properly cemented and tight and that the whole was left in clean and good condition.

Measurement used was 28' feet from North M.H. Depth of connection at point of tap 10' 2"  
Depth of connection at lot line 10' 2" Connection in house made to sanitary fixture

Roofwater ~~will be~~ is (not) conducted under my contract to

E. V. Biedeman Licensed Sewer Builder  
Approved 4-12-27 Ray B. Schell Inspector

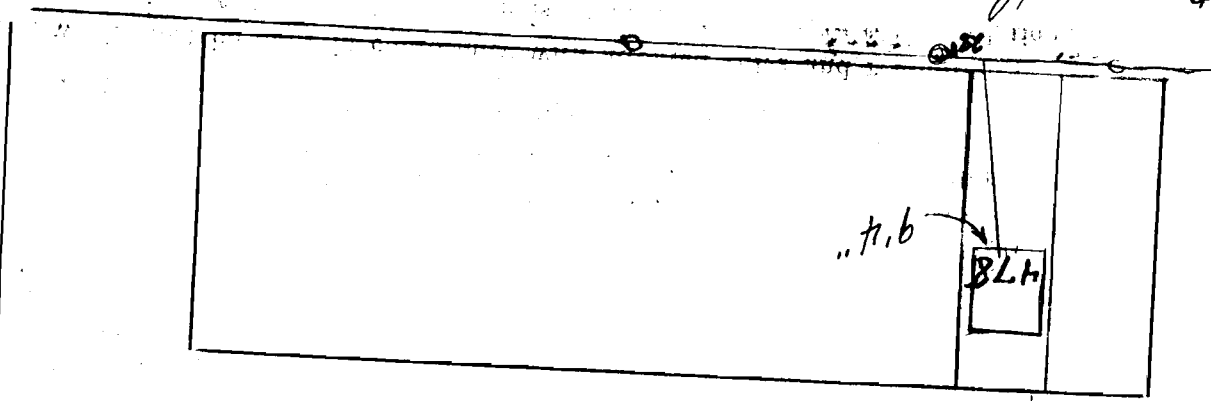

*Rosemont*

This plan should show street names and distances to manholes from Y or lateral being connected.

Permit No. 60  
Eastman  
Sewer District

SEWER CONNECTION

Lot No. 478  
Subdivision Pargate  
Street Rear of Rosemont

Recorded in Sewer Book  
Vol. 3, Pg. 126