


SEWER BUILDERS RETURN

I HEREBY CERTIFY that the within connection enters lot at a point 9' 4" feet south of
north line of said lot and was properly made by me on 6th day of June, 1927
in conformity with the specifications of Sanitary Engineering Department; that the connection was made with the recorded Y
branch or connection for said lot without opening or in any way injuring the main sewer; that said connection was laid to a
true and proper grade, and constructed of sound and substantial 5" vitrified sewer pipe, with the joints properly
cemented and tight and that the whole was left in clean and good condition.

Measurement used was 67' feet from north M.H. Depth of connection at point of tap 8' 6"
Depth of connection at lot line 7' 3" Connection in house made to house drain
Roofwater will be not conducted under my contract to roof

Approved J. C. Furlong Licensed Sewer Builder
Ray A. Sackett Inspector

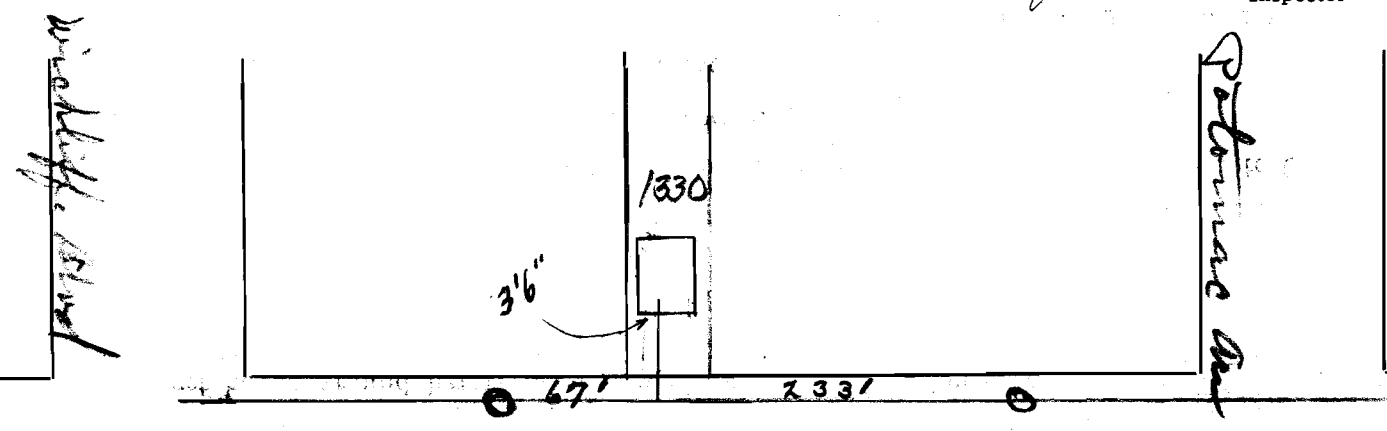

This plan should show street names and distances to manholes from Y or lateral being connected.

Permit No. 63
Wishkiffe Street
Sewer District

SEWER CONNECTION

Lot No. 1330
Subdivision Wishkiffe - Edgewood Sub
Street Edgewood Ave

Recorded in Sewer Book

Vol. 3, Pg. 103