


SEWER BUILDERS RETURN

I HEREBY CERTIFY that the within connection enters lot at a point 13' 4" feet south of north line of said lot and was properly made by me on 16th day of July, 1927. in conformity with the specifications of Sanitary Engineering Department; that the connection was made with the recorded Y branch or connection for said lot without opening or in any way injuring the main sewer; that said connection was laid to a true and proper grade, and constructed of sound and substantial 5" vitrified sewer pipe, with the joints properly cemented and tight and that the whole was left in clean and good condition.

Measurement used was 30' feet from north M.H. Depth of connection at point of tap 7' 6"
Depth of connection at lot line 4' 4" Connection in house made to house drain
Roofwater ~~is~~ is (not) conducted under my contract to Wm Hoppers

Approved 7-16-27 Ray Beckwith
Licensed Sewer Builder
Inspector

Potomac Ave

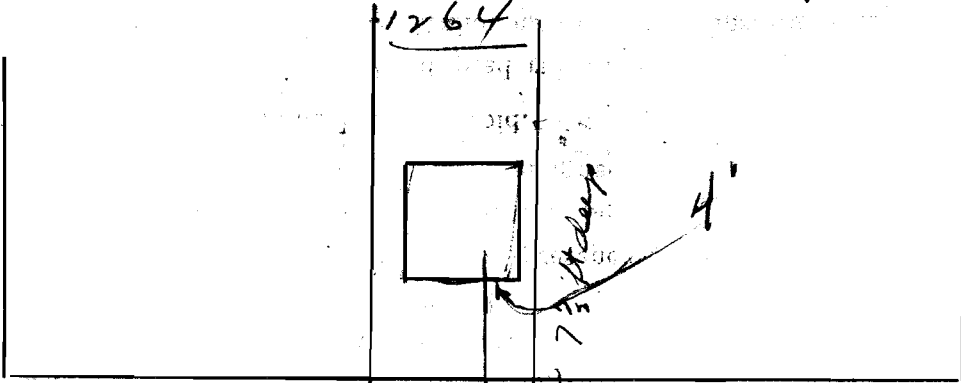

Wickliffe
Bldg.

Edgehill Drive

This plan should show street names and distances to manholes from Y or lateral being connected.

Permit No. 67

Quaintown
Sewer District

SEWER CONNECTION

Lot No. 1264

Subdivision Wickliffe-Clovermade

Street Edgehill Drive

Recorded in Sewer Book

Vol. 3, Pg. 103

601
337
274
27
300
109