


SEWER BUILDERS RETURN

I HEREBY CERTIFY that the within connection enters lot at a point 4' 7" feet north of south line of said lot and was properly made by me on 1st day of Aug. 1927 in conformity with the specifications of Sanitary Engineering Department; that the connection was made with the recorded Y branch or connection for said lot without opening or in any way injuring the main sewer; that said connection was laid to a true and proper grade, and constructed of sound and substantial 5" vitrified sewer pipe, with the joints properly cemented and tight and that the whole was left in clean and good condition.

Measurement used was 76' 6" feet from north M.L. Depth of connection at point of tap 9'  
 Depth of connection at lot line 7' Connection in house made to house drain  
 Roofwater is (not) conducted under my contract to \_\_\_\_\_

Wm. M. Hoffman  
 Licensed Sewer Builder  
 Approved 8-1-27 Ray K. Bachtel  
 Inspector

Wickham Bldg.

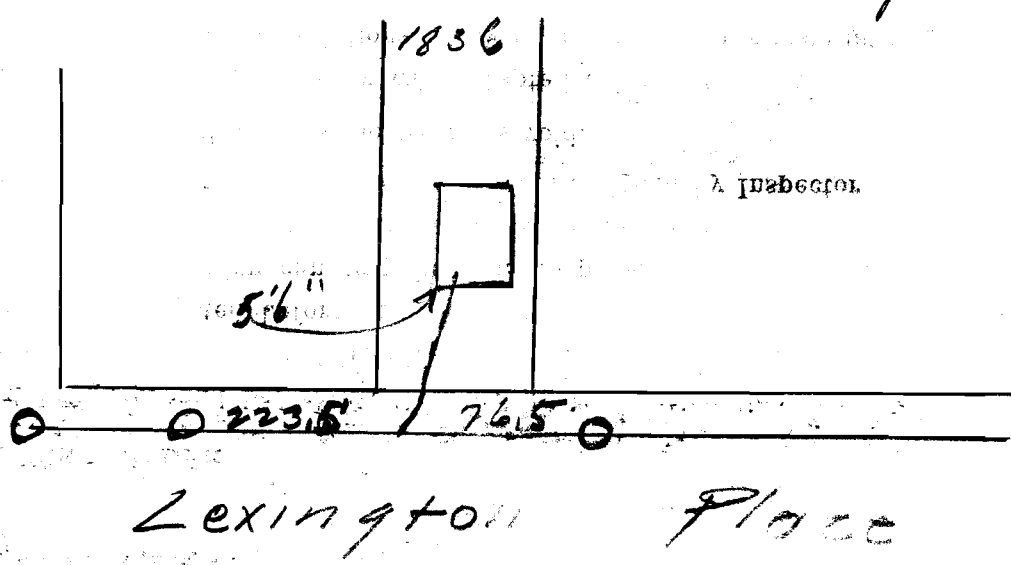

Dordale Ave

This plan should show street names and distances to manholes from Y or lateral being connected.

Permit No. 70

Dudman  
 Sewer District

SEWER CONNECTION

Lot No. 1836

Subdivision Commercial Vch

Street Lexington

Recorded in Sewer Book

Vol. 3, Pg. 143

Yard  
 323.6  
76.4  
 223.6  
100  
 100.0