


SEWER BUILDERS RETURN

I HEREBY CERTIFY that the within connection enters lot at a point 8'6" feet north of south line of said lot and was properly made by me on 30th day of July, 1927 in conformity with the specifications of Sanitary Engineering Department; that the connection was made with the recorded Y branch or connection for said lot without opening or in any way injuring the main sewer; that said connection was laid to a true and proper grade, and constructed of sound and substantial 5" vitrified sewer pipe, with the joints properly cemented and tight and that the whole was left in clean and good condition.

Measurement used was 105'6" feet from south M.H. Depth of connection at point of tap 9'6" Depth of connection at lot line 8'8" Connection in house made to house drain Roofwater will be is (not) conducted under my contract to

R. C. Bloomberg Licensed Sewer Builder
Approved 7-30-27 Ray B. Burtell Inspector

Wickliffe Blvd.

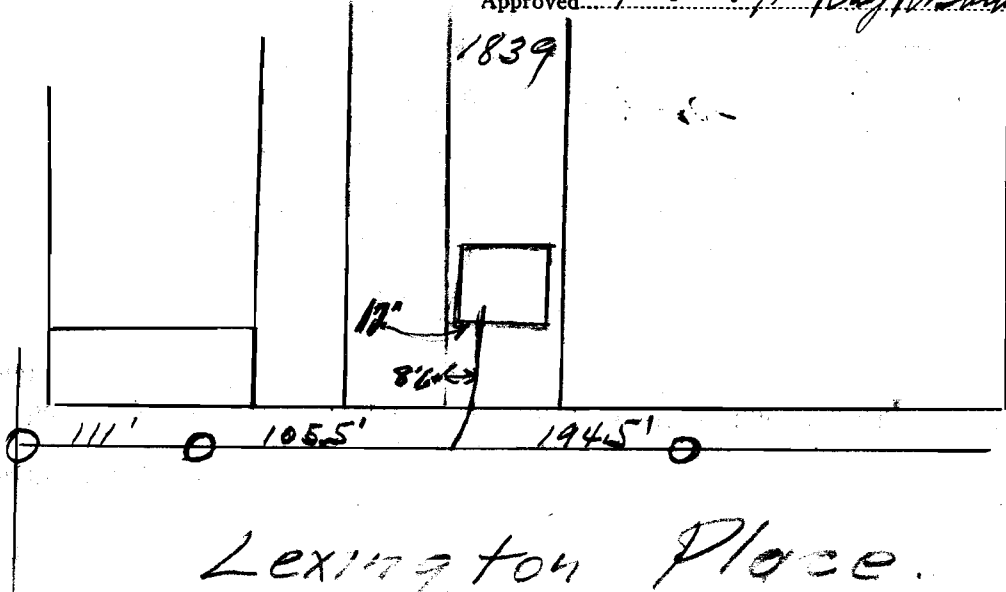

Oakdale Ave.

Lexington Place.

This plan should show street names and distances to manholes from Y or lateral being connected.

Permit No. 71
Wickliffe Commercial
Sewer District

SEWER CONNECTION

Lot No. 1839
Subdivision Wickliffe Commercial
Street Lexington Place

Recorded in Sewer Book

Vol. 3, Pg. 143

194.5
105.1
100
400.0