


SEWER BUILDERS RETURN

I HEREBY CERTIFY that the within connection enters lot at a point 6'6" feet North of South line of said lot and was properly made by me on 11 day of Aug., 1927. in conformity with the specifications of Sanitary Engineering Department; that the connection was made with the recorded Y branch or connection for said lot without opening or in any way injuring the main sewer; that said connection was laid to a true and proper grade, and constructed of sound and substantial 5" vitrified sewer pipe, with the joints properly cemented and tight and that the whole was left in clean and good condition.

Measurement used was 146' feet from and M.H. Depth of connection at point of tap 9' Depth of connection at lot line 6-3 Connection in house made to Soil Pipe Roofwater will be is (not) conducted under my contract to

W. M. Hoffman Licensed Sewer Builder  
Approved 8-11-27 Ray Bucklett Inspector

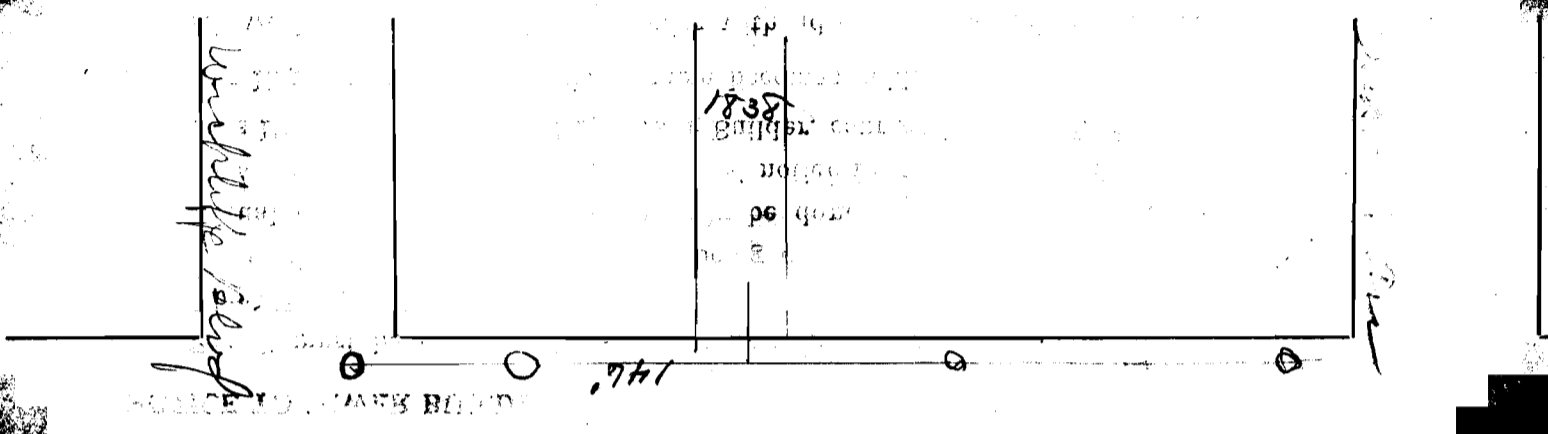

This plan should show street names and distances to manholes from Y or lateral being connected.

Permit No. 75  
Washington  
Sewer District

SEWER CONNECTION

Lot No. 1838  
Subdivision Wabasha Commercial  
Street Lexington Place

Recorded in Sewer Book

Vol. 3, Pg. 143