

SEWER BUILDERS RETURN

I HEREBY CERTIFY that the within connection enters lot at a point *at 9ft West of B. 90th St* feet *8-6*

.....line of said lot and was properly made by me on *Aug 22* day of *Aug*  
in conformity with the specifications of Sanitary Engineering Department; that the connection was made with the recorded Y  
branch or connection for said lot without opening or in any way injuring the main sewer; that said connection was laid to a  
true and proper grade, and constructed of sound and substantial *5* sewer pipe, with the joints properly  
cemented and tight and that the whole was left in clean and good condition.

Measurement used was *11.1* feet from *E. Manhole Sta 7* Depth of connection at point of tap *8-6*

Depth of connection at lot line *8* Connection in house made to .....


Roofwater *will be* is (not) conducted under my contract to .....

*N. M. Hoffmann*  
Licensed Sewer Builder

Approved *W. M. Hynes* Inspector

*Chas. E. ...*

*Raccoon ...*

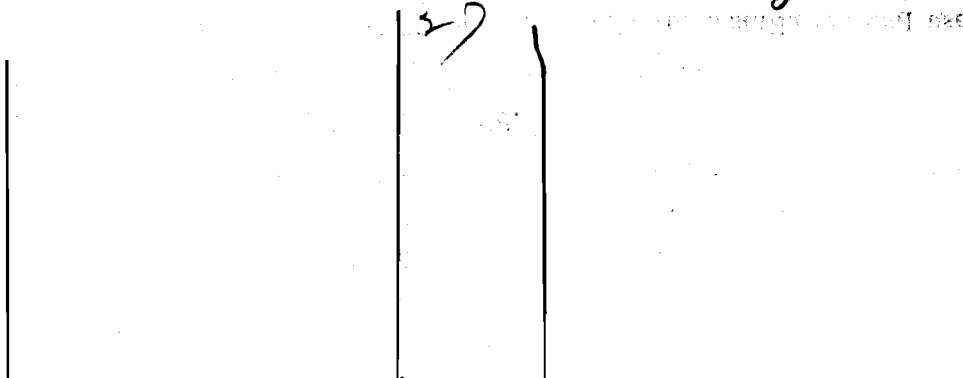

*Mahoning Ave*

This plan should show street names and distances to manholes from Y or lateral being connected.

Permit No. *81*

*Tenth*  
Sewer District

SEWER CONNECTION

Lot No. *27*

Subdivision *Mahoning Hgts*

Street *Mahoning Ave*

Recorded in Sewer Book

Vol. *3*, Pg. *147*

*2*