


SEWER BUILDERS RETURN

I HEREBY CERTIFY that the within connection enters lot at a point 3 feet West  
E. Lot line of said lot and was properly made by me on Sept 29 day of Sept  
in conformity with the specifications of Sanitary Engineering Department; that the connection was made with the recorded Y  
branch or connection for said lot without opening or in any way injuring the main sewer; that said connection was laid to a  
true and proper grade, and constructed of sound and substantial 5 sewer pipe, with the joints properly  
cemented and tight and that the whole was left in clean and good condition.

Measurement used was 215.9 feet from 5 M.H. Depth of connection at point of tap 9  
Depth of connection at lot line 5 Connection in house made to old sewer

Roofwater will be conducted under my contract to \_\_\_\_\_  
is (not) \_\_\_\_\_

Wm. W. Hoffmann  
Licensed Sewer Builder  
Approved W. W. Hynes  
Inspector

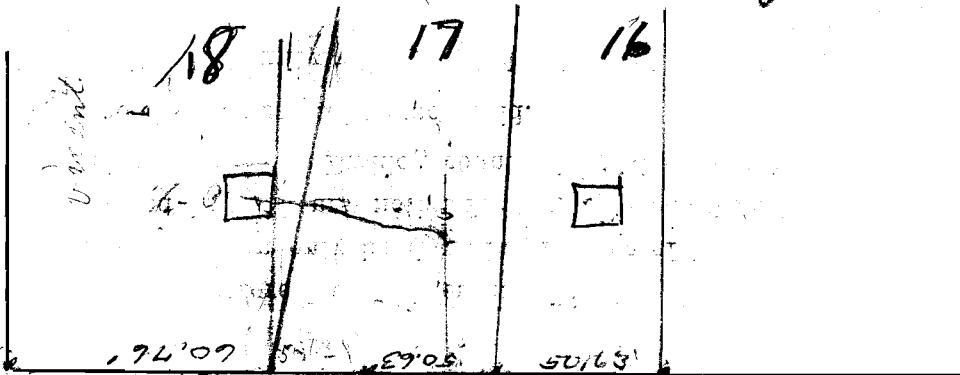

This plan should show street names and distances to manholes from Y or lateral being connected.

Permit No. 84  
Anderson  
Sewer District

SEWER CONNECTION  
Lot No. 17  
Subdivision Mahoning Hgts  
Street Mahoning Ave

Recorded in Sewer Book  
Vol. 1, Pg. 149

Void  
2-7-58  
Grant to  
Permit 2135  
2364  
2229  
92  
719'  
2264  
2250