


SEWER BUILDERS RETURN

I HEREBY CERTIFY that the within connection enters lot at a point 56-6 feet South of M. Manhole line of said lot and was properly made by me on 15 day of Sept in conformity with the specifications of Sanitary Engineering Department; that the connection was made with the recorded Y branch or connection for said lot without opening or in any way injuring the main sewer; that said connection was laid to a true and proper grade, and constructed of sound and substantial 5 sewer pipe, with the joints properly cemented and tight and that the whole was left in clean and good condition.

Measurement used was 53 feet from M. Manhole Depth of connection at point of tap 8
Depth of connection at lot line 7 Connection in house made to hall
Roofwater will be conducted under my contract to hall
is (not) is

W. M. Hoffman Licensed Sewer Builder
Approved W. M. Hoffman Inspector

Metrose Ave.

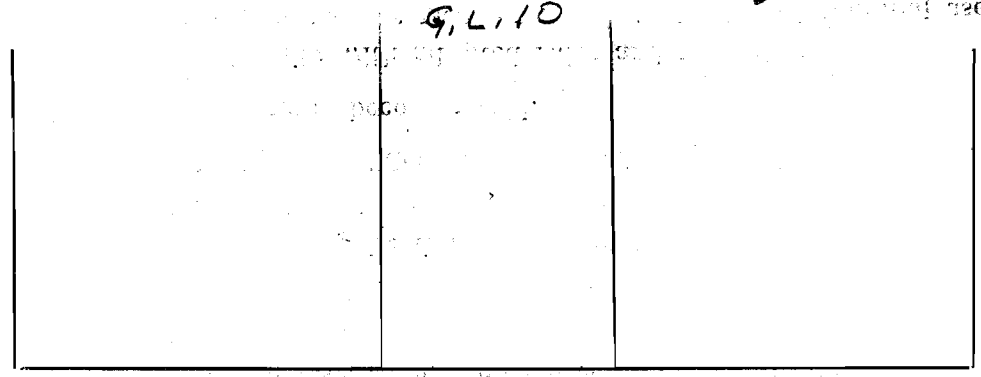

Mahoning Ave.

Raccoon Rd

This plan should show street names and distances to manholes from Y or lateral being connected.

Permit No. 88
Anderson
Sewer District

SEWER CONNECTION

Lot No. B L. 10
Subdivision Anderson Tract
Street Raccoon Rd

Recorded in Sewer Book

Vol. 3, Pg. 150