


SEWER BUILDERS RETURN

I HEREBY CERTIFY that the within connection enters lot at a point... feet North
West line of said lot and was properly made by me on 27 day of Sept 1927
in conformity with the specifications of Sanitary Engineering Department; that the connection was made with the recorded Y
branch or connection for said lot without opening or in any way injuring the main sewer; that said connection was laid to a
true and proper grade, and constructed of sound and substantial... sewer pipe, with the joints properly
cemented and tight and that the whole was left in clean and good condition.

Measurement used was 3' Ext feet from M.H 3*75 Depth of connection at point of tap 8'
Depth of connection at lot line 5' 4" Connection in house made to Toilet + Sinks
Roofwater will be
is (not) conducted under my contract to

Donatella Contracting Co
Licensed Sewer Builder
Approved W. M. Hyman Inspector

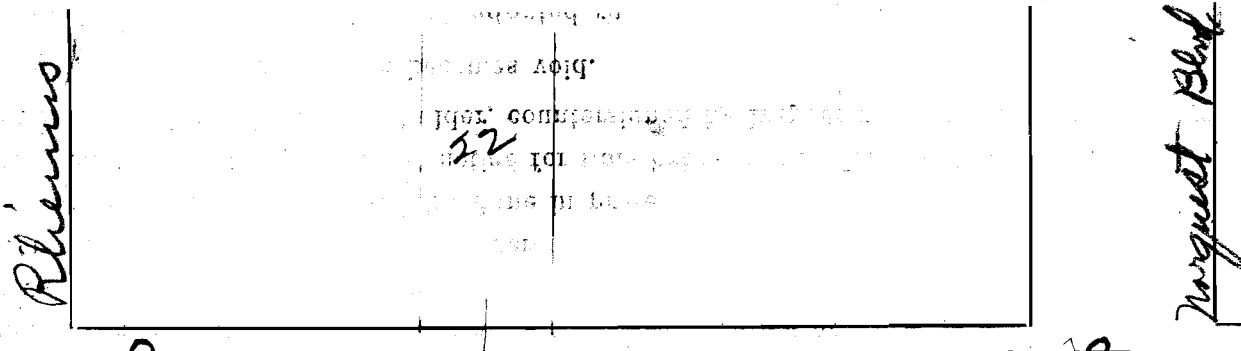

Plains

August Blvd

This plan should show street names and distances to manholes from Y or lateral being connected.

Permit No. 93
Winstone
Sewer District

SEWER CONNECTION

Lot No. 22
Subdivision Mahoning Heights
Street Mahoning Ave East
Recorded in Sewer Book

Vol. 3, Pg. 146