


SEWER BUILDERS RETURN

I HEREBY CERTIFY that the within connection enters lot at a point 31 feet East of West line of said lot and was properly made by me on 27 day of Sept 1927 in conformity with the specifications of Sanitary Engineering Department; that the connection was made with the recorded Y branch or connection for said lot without opening or in any way injuring the main sewer; that said connection was laid to a true and proper grade, and constructed of sound and substantial sewer pipe, with the joints properly cemented and tight and that the whole was left in clean and good condition.

Measurement used was 112 feet from MH 23X61 Depth of connection at point of tap 8'
Depth of connection at lot line 5' 4" Connection in house made to Wells & Sinks
Roofwater will be conducted under my contract to is (not)

Donatella Contracting Co
Licensed Sewer Builder
Approved W. M. Hynes Inspector

5' 4"

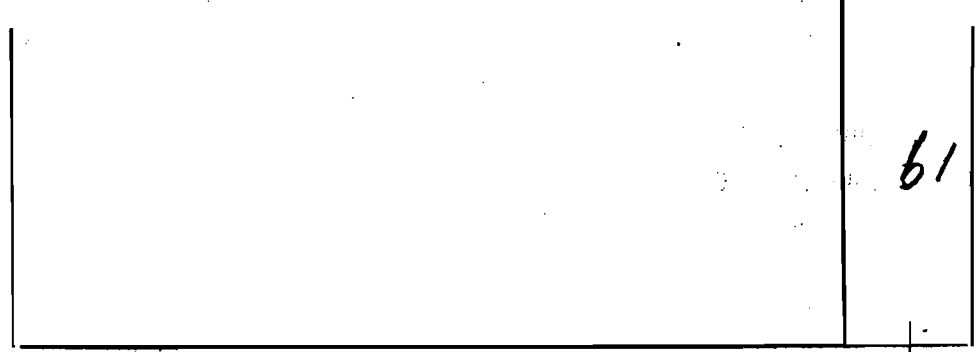

Donatella

0
INCHES

This plan should show street names and distances to manholes from Y or lateral being connected.

Permit No. 94
Contractor
Sewer District

SEWER CONNECTION

Lot No. 29
Subdivision Mahoning Heights
Street Mahoning Ave East

Recorded in Sewer Book

Vol. 3, Pg. 149

made for 19
Sept 1927