


SEWER BUILDERS RETURN

I HEREBY CERTIFY that the within connection enters lot at a point 14' feet south of north line of said lot and was properly made by me on 11th day of Oct. 1927 in conformity with the specifications of Sanitary Engineering Department; that the connection was made with the recorded Y branch or connection for said lot without opening or in any way injuring the main sewer; that said connection was laid to a true and proper grade, and constructed of sound and substantial 5" vitrified sewer pipe, with the joints properly cemented and tight and that the whole was left in clean and good condition.

Measurement used was 95' feet from North 9m Depth of connection at point of tap 8'-4"
 Depth of connection at lot line 4' Connection in house made to main drain
 Roofwater will be conducted under my contract to surface
 is (not) is

Approved 10-11-27 Wm. Hoffmann
 Licensed Sewer Builder
Ray B. Bickel
 Inspector

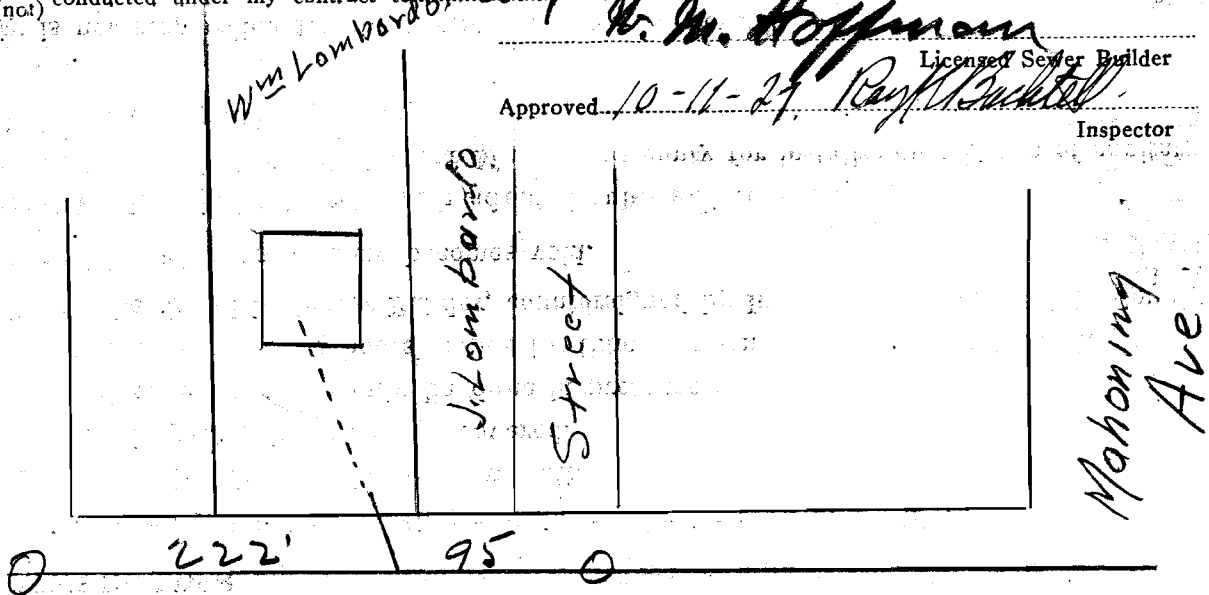

Raccoon Road

This plan should show street names and distances to manholes from Y or lateral being connected.

Permit No. 97
Quakertown
 Sewer District

SEWER CONNECTION

Lot No. Q. L. 10
 Subdivision Quakertown Park
 Street Raccoon Rd

Recorded in Sewer Book
 Vol. 3, Pg. 150

4.35
3.40
95

657
431

6