

SEWER BUILDERS RETURN

I HEREBY CERTIFY that the within connection enters lot at a point 12'-2" feet North of South line of said lot and was properly made by me on 7th day of Oct., 1927 in conformity with the specifications of Sanitary Engineering Department; that the connection was made with the recorded Y branch or connection for said lot without opening or in any way injuring the main sewer; that said connection was laid to a true and proper grade, and constructed of sound and substantial 5" vitrified sewer pipe, with the joints properly cemented and tight and that the whole was left in clean and good condition.


Measurement used was 30'6" feet from W. side Depth of connection at point of tap 7
Depth of connection at lot line 4 ft Connection in house made to Sail Stack
Roofwater will be conducted under my contract to W. Mc Hoffman

W. Mc Hoffman Licensed Sewer Builder
Approved 10-7-27 Ray Bachtell Inspector

Corkdale Ave.

Cellar by main sewer
connected in this lot so
good.

NICKLE
Bldg

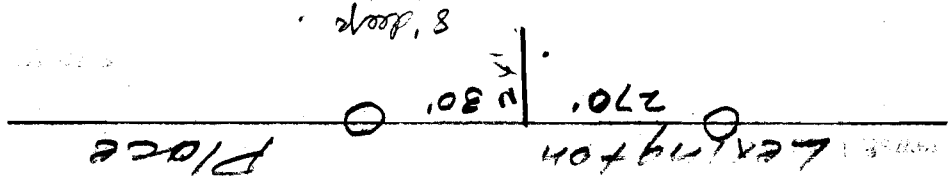

This plan should show street names and distances to manholes from Y or lateral being connected.

Permit No. 99

Austin
Sewer District

SEWER CONNECTION

Lot No. 1850

Subdivision Commercial Sub

Street Lexington St

Recorded in Sewer Book

Vol. 3, Pg. 143

270
30
00
00
00