


SEWER BUILDERS RETURN

I HEREBY CERTIFY that the within connection enters lot at a point 7 feet West of  
East property line of said lot and was properly made by me on 28 day of Aug. 1925  
in conformity with the specifications of Sanitary Engineering Department; that the connection was made with the recorded Y  
branch or connection for said lot without opening or in any way injuring the main sewer; that said connection was laid to a  
true and proper grade, and constructed of sound and substantial retreats sewer pipe, with the joints properly  
cemented and tight and that the whole was left in clean and good condition.

Measurement used was 102 feet from manhole. Depth of connection at point of tap 7 1/2 FT.  
Depth of connection at lot line 6 ft. Connection in house made to inside of collar wall  
Roofwater is (not) conducted under my contract to \_\_\_\_\_

Approved Beede & Beede Per 715 Beede  
James Prier Licensed Sewer Builder  
Inspector

FIRINLEY AVE.

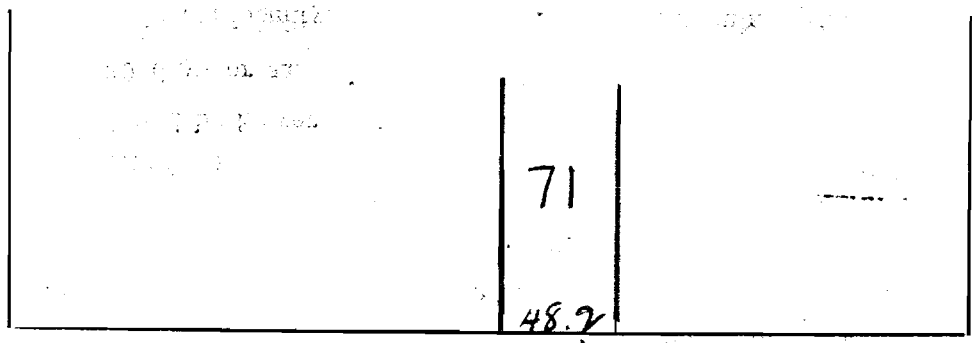

ARAVESTA AVE

SHIELDS ROAD

This plan should show street names and distances to manholes from Y or lateral being connected.

Permit No. 129 46  
Beachwood Sewer District

SEWER CONNECTION

Lot No. 71  
Subdivision Beachwood  
Street Shields Road

Recorded in Sewer Book

Vol. 1, Pg. 157